


Dickinson

Form 51-5M-4-27-27423

Map No. **KANSAS** Sec. 6 Twp. 16^S R. 1^E

Well No. 1 - Eliason Farm

Union Oil & Gas Company

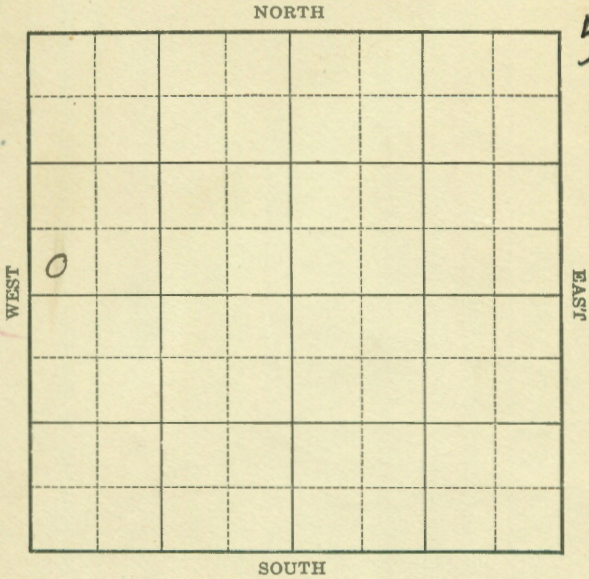

Location _____

Drilling Remarks _____

Rig Up _____

Drilling Remarks _____

RECORD

Cased _____ in. _____ ft.

Sand _____

Gas _____

Oil _____

Total Depth _____

PRODUCTION

1st 24 hrs. Nat. _____

1st 24 hrs. after shot _____

Gas _____ cu. ft.

Dry Hole _____

Abandoned _____

Map No. **KANSAS** Sec. _____ Twp. _____ R. _____

Well No. _____ Farm _____


_____ Company _____

_____ Ft. from N. Line

_____ Ft. from S. Line

_____ Ft. from E. Line

_____ Ft. from W. Line

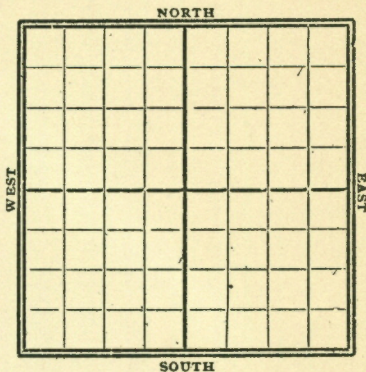

917

Date

REPORT

1/6

Abd T.O. 2725'

Gypsy Records

Dickerson

MAP NO. **KANSAS** SEC. 6 TWP. 16S R. 1E

WELL NO. 1 E. Union

Union Oil & Gas

COMPANY

CONTRACTOR

SW SW NW

SECTION PLAT

ABANDONED

_____ FT. FROM N. LINE
_____ FT. FROM S. LINE
_____ FT. FROM E. LINE
_____ FT. FROM W. LINE

NO RECORD

LOCATION _____

RIG UP _____

DRILLING AND REMARKS:

WINDY
SCOUT HAS
NEVER REPORTED
NOTHING IN FILES

RECORD

CASED _____ IN., _____ FT.
SAND _____
GAS _____
OIL _____
TOTAL DEPTH 2725

PRODUCTION

1ST 24 HRS. NAT. _____
1ST 24 HRS. AFTER SHOT _____
GAS _____ CU. FT.
DRY HOLE
ABANDONED

DATE

Jan 6 1917

SCOUT