


Map No. KANSAS Sec. 10 Twp. 16 R. 7 E
 Well No. 1 Mitcalf Farm
General Utility Co. Company

NORTH

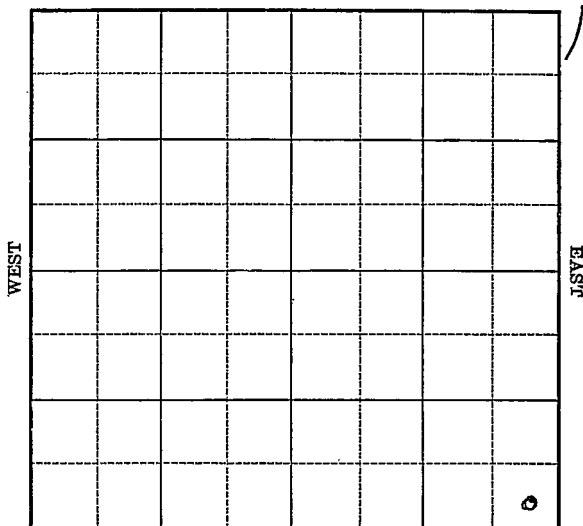

SOUTH

Location _____

Drilling Remarks

RECORD

Cased _____ in. _____ ft.
 Sand _____
 Gas _____
 Oil _____
 Total Depth _____

Rig Up _____

Drilling Remarks

PRODUCTION

1st 24 hrs. Nat. _____
 1st 24 hrs. after shot _____
 Gas _____ cu. ft.
 Dry Hole _____
 Abandoned _____


morris

Map No. Kansas Sec. 10 Twp. 16 R. 7^E
 Well No. 1 Metcalf Farm
General Utility Co Company

.....Ft. from N. Line

300 Ft. from S. Line300 Ft. from E. Line

.....Ft. from W. Line

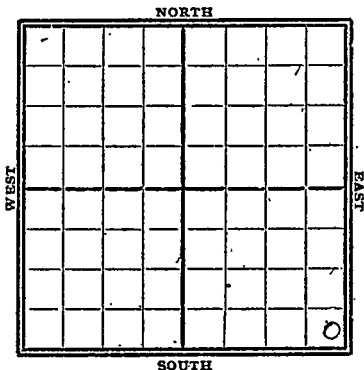Date
1928

REPORT

8/1 machine
 8/19 Rigging up
 8/16 Drilg 520
 8/23 " 1120
 8/28 _____
 9/4 S.D. 1120
 9/12 _____
 9/19 sand 1415-20
 T.D. - 1430
 1/2 ft gas
 Comp as gas well

Morriss

27 KANSAS

MAP No. _____ SEC. 10 TWP. 16 R. 7^E

WELL No. 1. Metcalf

General Utility Co

COMPANY

CONTRACTOR

FIRST REPORTS

_____ FT. FROM N. LINE

300

_____ FT. FROM S. LINE

300

_____ FT. FROM E. LINE

_____ FT. FROM W. LINE

SECTION PLAT

			0

LOCATION

RIG UP

DRILLING AND REMARKS:

Machine

RECORD

CASED _____ IN. _____ FT.

SAND _____

GAS _____

OIL _____

TOTAL DEPTH _____

PRODUCTION

1ST 24 HRS. NAT. _____

1ST 24 HRS. AFTER SHOT _____

GAS _____ CU. FT.

DRY HOLE _____

ABANDONED _____

DATE

AUG 1 1928

CHAS. L. SHERWOOD

192

SCOUT

Marvis
 K 27 KANSAS SEC. 10 TWP. 16 R. 7
 MAP NO. 1 *Hetcher*
 WELL NO. General Utility Co COMPANY

CONTRACTOR

COMPLETED

SECTION PLAT

			0

Ft. FROM N. LINE

300

Ft. FROM S. LINE

300

Ft. FROM E. LINE

Ft. FROM W. LINE

LOCATION _____

RIG UP _____

DRILLING AND REMARKS:

gas well

RECORD

CASED _____ IN. _____ FT.

SAND 1415-1420

GAS _____

OIL _____

TOTAL DEPTH 1430

PRODUCTION

1ST 24 HRS. NAT. _____

1ST 24 HRS. AFTER SHOT _____

GAS 1/2 M CU. FT.

DRY HOLE _____

ABANDONED _____

DATE

SEP 19 1928

CHAS. L. SHERWOOD

192

SCOUT