

Section 16 Township 16 Range 11 E

Sec. 16 Twp. 16 R. 11E

Well No. # 1 Day

Well No. #1 Day Farm

Company Midge Oil

Midge Oil Company

White & Ellis Contractor
Wildcat



330 Ft. from N. Line

..... Ft. from S. Line

330 Ft. from E. Line

..... Ft. from W. Line

NE NE SE

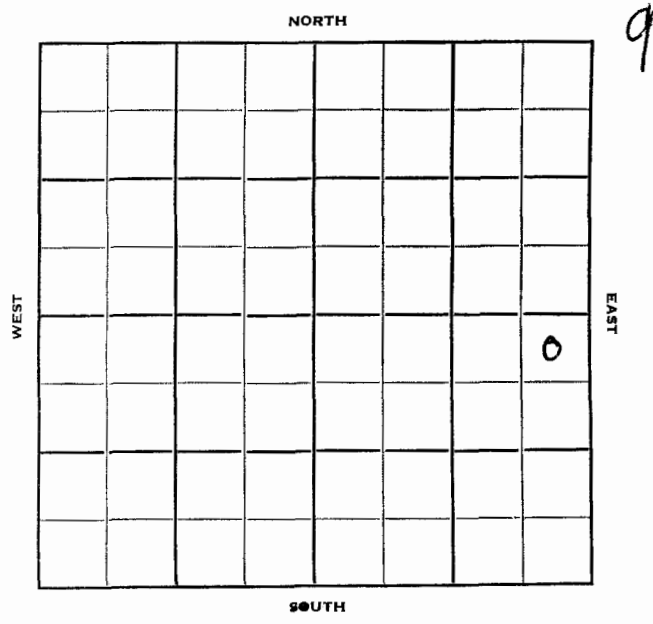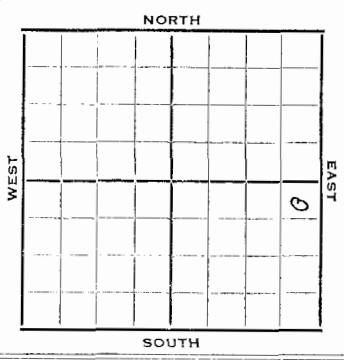

1952	Est. 1390'	REPORT
6/25	Spud 6-13-52 8" @ 120' Lans. 1392 B KC 1719 Drlg. 2400'	KC 1500 Miss. 2363
7/23	Spud 6-18-52 D&A TD 3134 8" @ 120'	
	DST 2908-15 opn 1 hr. Rec. 60' msoc 120' sul wtr. 800#	
	DST 3064-91 opn 1/2 hr. Rec. 30' h oil 20' hocm 120' sw 845# TD 3134	
	$\begin{array}{r} 2363 \\ 1390 \\ \hline .973 \end{array}$	

