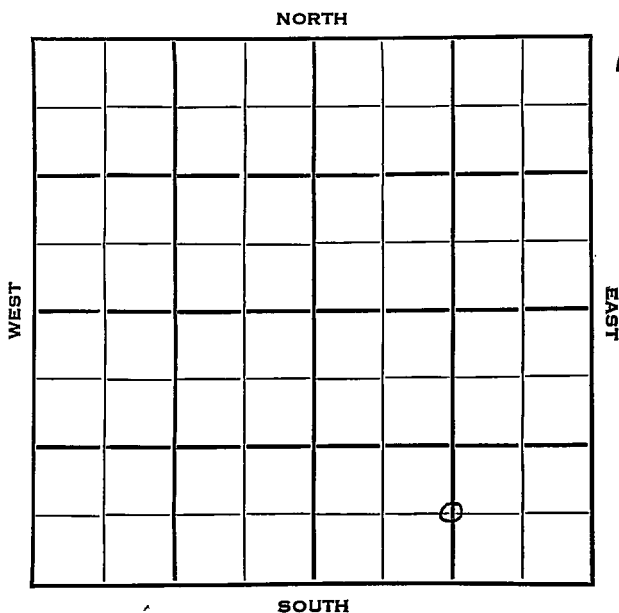


Section 11 Township 16 Range 7EWell No. 1 B_rewerCompany Seibel

Morris

KANSAS ✓

Sec. 11 Twp. 16 R. 7EWell No. 1 Brewer FarmSeibel Company


Contractor

Ft. from N. Line

660 Ft. from S. Line1320 Ft. from E. Line

Ft. from W. Line

C S/2 SE

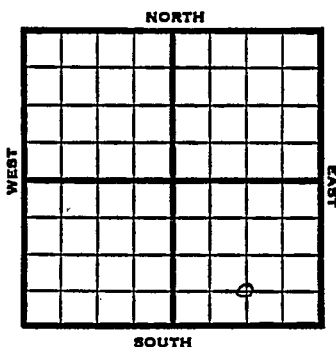

1953


Elev. 1476' REPORT

1/7

Spudding Dated 1/3/53
10" @ 136 Drlg. 160

1/14

Spud 1-3-53
D&A
TD 1485
10" @ 136
7" @ 1291
Lans 1390
TD 1485
D&A**ABANDONED**

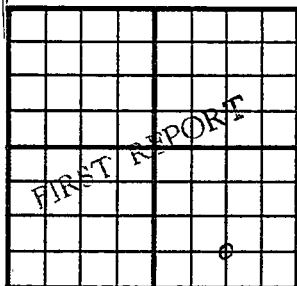County Morris State KansasSec. 11 (Blk.) 16 (Sur.) 7E Map No.Operator SeibelWell No. 1 Farm BrewerElev. Location C S $\frac{1}{2}$ SE660 Ft. From S Line SE1320 Ft. From E Line Quarter1st. Report JAN 7 1953


Completion

Remarks

Spudding Date 1-3-53

Drlg. Data

10" @ 136 drlg. 160

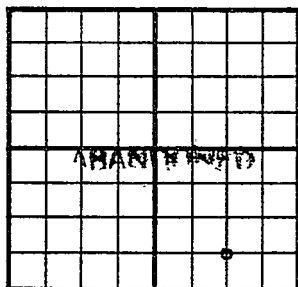County Morris State KansasSec. 11 (Blk.) 16 (Sur.) 7E Map No.Operator SeibelWell No. 1 Farm BrewerElev. 1476 Location C S $\frac{1}{2}$ SE660 Ft. From S Line SE1320 Ft. From E Line Quarter

1st. Report

Completion JAN 14 1953

Remarks

Spudding Date 1-3-53Drlg. Data D & A TD 148510" @ 136 7" @ 1291 Lans. 1390TD 1485D & A

J. G. McGEHEE