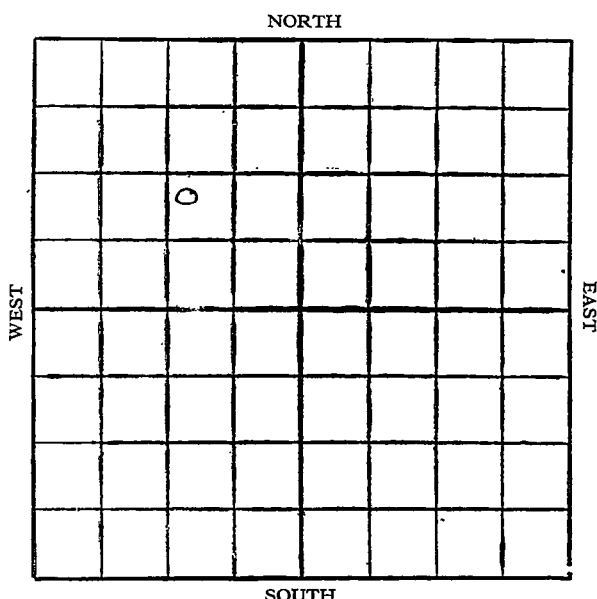


Map No. 15 Sec. 14 Twp. 16 R. 7EWell No. 1-Hammer Farm
C. A. Nicoll et al company

Location

Drilling Remarks

Rig Up

Drilling Remarks

RECORD

Cased in. ft.

Sand

Gas

Oil

Total Depth

PRODUCTION

1st 24 hrs. Nat.

1st 24 hrs. after shot

Gas cu. ft.

Dry Hole


Abandoned

Map No. Kansas Sec. 14 Twp. 16 R. 7^EWell No. 1 Hammer FarmC. A. Nicoll et al Company

_____ Ft. from N. Line

1120 Ft. from S. Line1120 Ft. from E. Line

_____ Ft. from W. Line

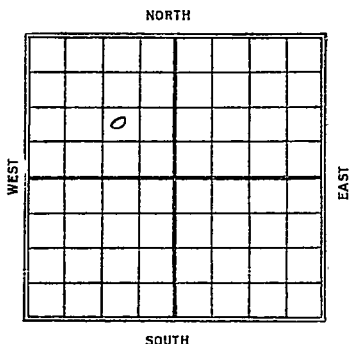Date
1927

REPORT

1/19 Slg 5001/26 Same2/3 —2/10 —2/17 —4/23 Drlg 12353/2 —3/9 —3/16 —3/24 —3/30 S.D. 12354/6 sand 1448-1459I.O. 14592 mil gas

Morris
 27 KANSAS
 Map No. _____ Sec. *14* Twp. *16* R. *7* ^E
 Well No. *1 Hammer*
C. H. Nicoll et al Company

Contractor

FIRST REPORTS

SECTION PLAT

_____ Ft. from N. Line

1120 Ft. from S. Line*1120* Ft. from E. Line

_____ Ft. from W. Line

	0		

Location _____

Rig up _____

Drilling and Remarks:

*Only 500'**Mac line*

RECORD

Cased _____ in., _____ ft.

Sand _____

Gas _____

Oil _____

Total Depth *1120*

PRODUCTION

1st 24 hrs. Nat. _____

1st 24 hrs. after shot _____

Gas _____ Cu. Ft.

Dry Hole _____

Abandoned _____

Date

JAN 19 1927

CHAS. L. SHERWOOD

192

Scout

Morris
 27 KANSAS
 Map No. _____ Sec. 14 Twp. 16 R. 7
 Well No. 1 Hammer
 C. H. Nicoll et al Company

Contractor

COMPLETED

SECTION PLAT

	0		

_____ Ft. from N. Line

1120 _____ Ft. from S. Line

1120 _____ Ft. from E. Line

_____ Ft. from W. Line

Location _____

Rig up _____

Drilling and Remarks:

So. Well

RECORD

Cased _____ in., _____ ft.

Sand 1448-1459

Gas _____

Oil _____

Total Depth 1459

PRODUCTION

1st 24 hrs. Nat. _____

1st 24 hrs. after shot _____

Gas $\checkmark$ ~~AA~~ _____ Cu. Ft.

Dry Hole _____

Abandoned _____

Date

APR 6 1927

CHAS. L. SHERWOOD

192

Scout