

# KANSAS

Morris ✓

Section 15 Township 16 Range 7E

Well No. 1 Orphans Home

Company Westgate-Greenland

Wildcat

NORTH

WEST

EAST

SOUTH

							0

16

Sec. 15 Twp. 16 R. 7E

Well No. #1 Orphans Home Farm

Westgate-Greenland Company

Wildcat (Jackson, Cont.)

NORTH

\_\_\_\_\_ Ft. from N. Line

330'


\_\_\_\_\_ Ft. from S. Line

330'

\_\_\_\_\_ Ft. from E. Line

\_\_\_\_\_ Ft. from W. Line

SE/C

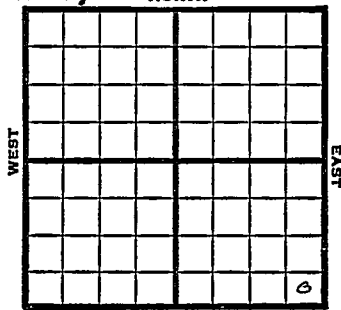

1949 Elev. 1460' REPORT

8/10 9" @ 120'  
Drlg. 500'

8/17 Lansing 1435'  
Arb. 1899'  
TD 2170'  
5" @ 1537'

8/24 "

8/31 71 shots 1400-10  
1000 acid  $\frac{1}{2}$  M Gas & wtr.

9/7 Arb. 1899'  
5" @ 1537'  
TD 2170'

ABANDONED

Map No. \_\_\_\_\_ Sec. 15 Twp. 16 R. 7E

Well No. 1 Orphans Home

Westgate-Greenland Company

Jackson Contractor

SE/C

FIRST REPORT  
 SECTION PLAT

\_\_\_\_\_ Ft. from N. Line

330 Ft. from S. Line

330 Ft. from E. Line

\_\_\_\_\_ Ft. from W. Line


Morris County

RECORD

Location \_\_\_\_\_

Cased \_\_\_\_\_ in., \_\_\_\_\_ ft.

Rig up \_\_\_\_\_

Sand \_\_\_\_\_

Drilling and Remarks:

Gas \_\_\_\_\_

9" @ 120

Oil \_\_\_\_\_

drlg. 500

Total Depth \_\_\_\_\_

PRODUCTION

1st 24 hrs. Nat. \_\_\_\_\_

1st 24 hrs. after shot \_\_\_\_\_

Gas \_\_\_\_\_ Cu. Ft.

Dry Hole \_\_\_\_\_

Abandoned \_\_\_\_\_

Date

AUG 10 1949

19.

S. J. LEWIS

Scout

