


Map No. KANSAS Sec. 15 Twp. 16 R. 7E
Well No. 2-Munnell Farm
Loomis, et al Company

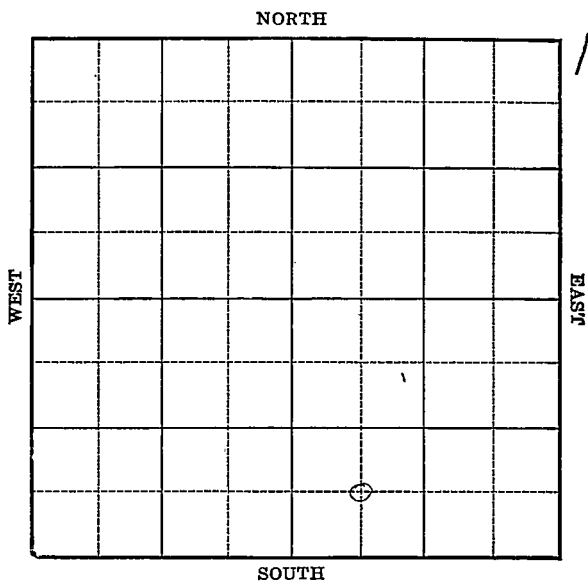

Location _____
Drilling Remarks _____

Rig Up _____
Drilling Remarks _____

RECORD

Cased _____ in. _____ ft.
Sand _____
Gas _____
Oil _____
Total Depth _____

PRODUCTION

1st 24 hrs. Nat. _____
1st 24 hrs. after shot _____
Gas _____ cu. ft.
Dry Hole _____
Abandoned _____

Map No. 1 ANSAS Sec. 15 Twp. 16 R. 7E

Well No. 2 Mumsee Farm
Loomis et al Company


 Ft. from N. Line

660 Ft. from S. Line

 Ft. from E. Line

660 Ft. from W. Line

1930

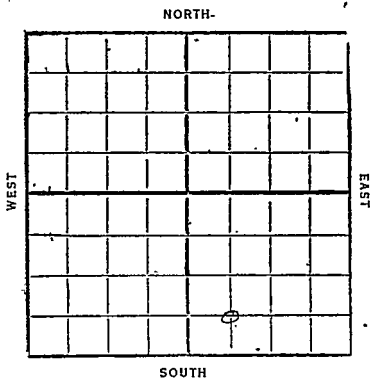

Date

REPORT

12/30	Run up
1931	
1/7	Drill 200'
1/14	SD 200'
1/21	—
1/28	—
2/4	—
2/11	—
2/18	—
2/25	—
3/3	Drill 180'
3/11	SD 180'
3/18	—
3/25	—
4/1	—
4/8	—
4/15	Drill 435'
4/22	SD 435'
4/29	—
5/7	T.D. 437
	1st gas
	Comp.

Morris E

Map No. KANSAS Sec. 15 Twp. 16 R. 7

Well No. 27 2 *Munself*

Loomis *et al* Company

Contractor

FIRST REPORTS

Ft. from N. Line

660 Ft. from S. Line

Ft. from E. Line

660 Ft. from W. Line

SECTION PLAT

Location

Rig up

Drilling and Remarks:

Rigging up.

RECORD

Cased _____ in., _____ ft.

Sand _____

Gas _____

Oil _____

Total Depth _____

PRODUCTION

1st 24 hrs. Nat. _____

1st 24 hrs. after shot _____

Gas _____ Cu. Ft.

Dry Hole _____

Abandoned _____

Date

DEC 3 0 1930

192

CHAS. L. SHERWOOD

Scout

27 *Moore*
 Map No. **KANSAS** Sec. *15* Twp. *16* R. *7*
 Well No. *2* *Munsel*
Moore & Co Company

Contractor

COMPLETED

SECTION PLAT

		0	

Ft. from N. Line

660 Ft. from S. Line

Ft. from E. Line

660 Ft. from W. Line

Location

Rig up

Drilling and Remarks:

RECORD

Cased _____ in., _____ ft.

Sand _____

Gas _____

Oil _____

Total Depth *437*

PRODUCTION

1st 24 hrs. Nat. _____

1st 24 hrs. after shot _____

Gas *1 M* Cu. Ft.

Dry Hole _____

Abandoned _____

Date

MAY 7

1931

CHAS. L. SHERWOOD

192

Scout