


Morris  
Form 51-5M-2-29-34703

Map No. **KANSAS** Sec. 15 Twp. 16 R. 7E

Well No. #3 Munnell Farm  
W. Loomis Company

NORTH

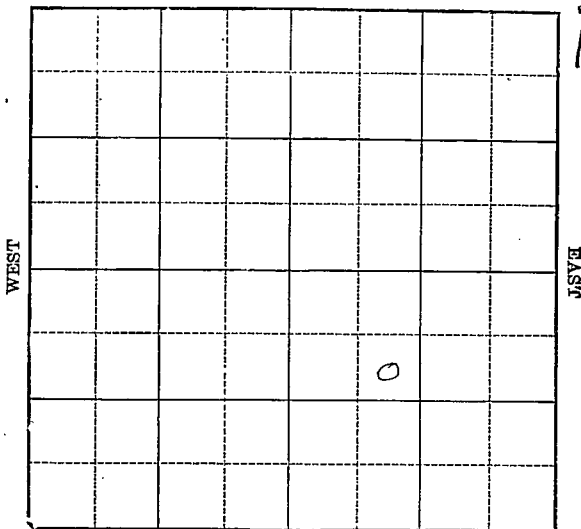

SOUTH

Location \_\_\_\_\_

Drilling Remarks \_\_\_\_\_  
\_\_\_\_\_  
\_\_\_\_\_  
Rig Up \_\_\_\_\_

Drilling Remarks \_\_\_\_\_  
\_\_\_\_\_  
\_\_\_\_\_  
**RECORD**

Cased \_\_\_\_\_ in. \_\_\_\_\_ ft.

Sand \_\_\_\_\_

Gas \_\_\_\_\_

Oil \_\_\_\_\_

Total Depth \_\_\_\_\_

**PRODUCTION**

1st 24 hrs. Nat. \_\_\_\_\_

1st 24 hrs. after shot \_\_\_\_\_

Gas \_\_\_\_\_ cu. ft. \_\_\_\_\_

Dry Hole \_\_\_\_\_

Abandoned \_\_\_\_\_



*Meris*27 KANSAS  
Map No. Sec. 15 Twp. 16 R. 7Well No. 3 *Munsee**Dr. Loomis* Company

Contractor

## CORRECTION

1070 Ft. from N. Line

Ft. from S. Line

Ft. from E. Line

1070 Ft. from W. Line

## SECTION PLAT


Location.....

Rig up.....

Drilling and Remarks:

*chg Well # from**#, to # 3.*

## RECORD

Cased..... in., *1* ft.

Sand.....

Gas.....

Oil.....

Total Depth.....

## PRODUCTION

1st 24 hrs. Nat.....

1st 24 hrs. after shot.....

Gas..... Cu. Ft.

Dry Hole.....

Abandoned.....

Date

AUG 12 1931

CHAS. L. SHERWOOD

192

Scout

*Meris*

Map No. **KANSAS** Sec. *15* Twp. *16* R. *7*

Well No. *27 3* *Munsee*

*Dr. Loomis* Company

Contractor

**COMPLETED**

**SECTION PLAT**

*1070* Ft. from N. Line

..... Ft. from S. Line

..... Ft. from E. Line

*1070* Ft. from W. Line


Location.....

Rig up.....

Drilling and Remarks:

**RECORD**

Cased..... in., ..... ft.

Sand.....

Gas.....

Oil.....

Total Depth: *438*

**PRODUCTION**

1st 24 hrs. Nat.....

1st 24 hrs. after shot.....

Gas: *100,000* Cu. Ft.

Dry Hole.....

Abandoned.....

Date

**AUG 26 1931**

**CHAS. L. SHERWOOD**  
192..... Scout

27 KANSAS

Map No. \_\_\_\_\_ Sec. 15 Twp. 16 R. 7 E

Well No. 1 *Munsee*

*Dr. Leemis* Company

Contractor

FIRST REPORTS

1070 Ft. from N. Line

\_\_\_\_\_ Ft. from S. Line

\_\_\_\_\_ Ft. from E. Line

1070 Ft. from W. Line

SECTION PLAT

		o	

Location \_\_\_\_\_

Rig up \_\_\_\_\_

Drilling and Remarks:

*Machine.*

RECORD

Cased \_\_\_\_\_ in., \_\_\_\_\_ ft.

Sand \_\_\_\_\_

Gas \_\_\_\_\_

Oil \_\_\_\_\_

Total Depth \_\_\_\_\_

PRODUCTION

1st 24 hrs. Nat. \_\_\_\_\_

1st 24 hrs. after shot \_\_\_\_\_

Gas \_\_\_\_\_ Cu. Ft.

Dry Hole \_\_\_\_\_

Abandoned \_\_\_\_\_

Date

JUL 8 1931

CHAS. L. SHERWOOD

192 \_\_\_\_\_ Scout