

Section 15 Township 16 Range 4E

Well No. #1 Pagenkopf

Company Meyers et al


Lost Spring Pool

NORTH

WEST

EAST

SOUTH

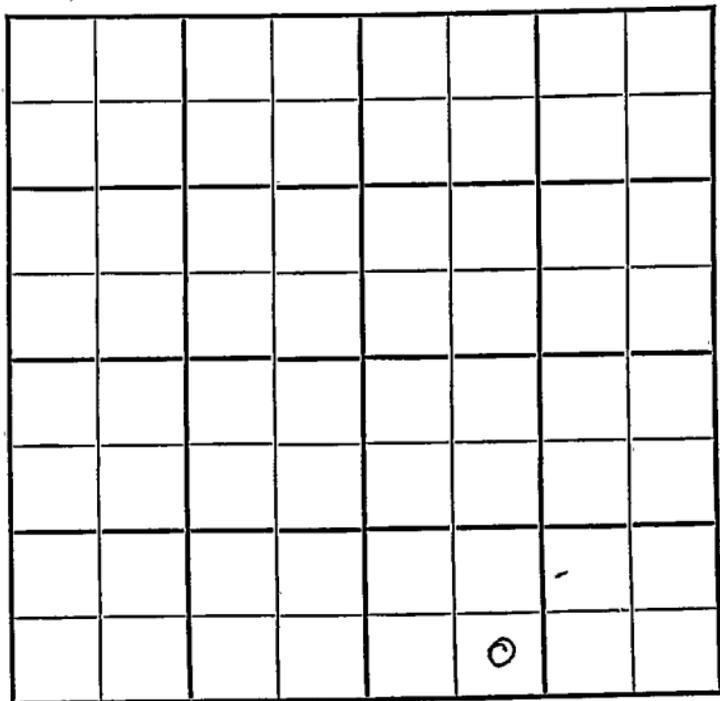

KANSAS

Dickinson



Sec. 15

Twp. 16

R. 4E

Well No. #1 Pagenkopf

Farm

Meyers et al

Company

Lost Spring Pool


Ft. from N. Line

330' Ft. from S. Line

Ft. from E. Line

990' Ft. from W. Line

SE SW SE

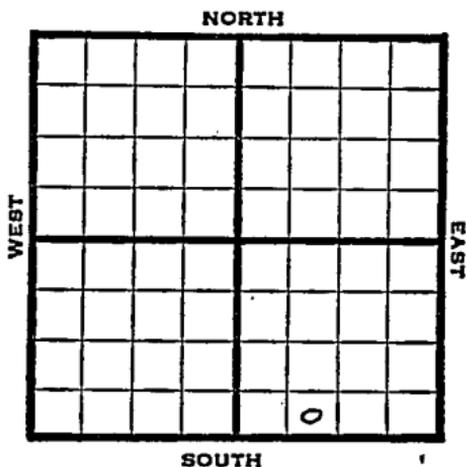

1948

REPORT

2/18

10" @ 115'
Miss. 2299'
TD 2304'
7" @ 2304'
RUST

2/25

Miss. 2299'
7" @ 2304'
TD 2360'
Abd.

ABANDONED

Map No. _____ Sec. 15 Twp. 16 R. 4E

Well No. 1 Pagenkopf

Meyers et al. _____ Company

FIRST REPORT

Contractor

SE SW SE

SECTION PLAT

_____ Ft. from N. Line

330 _____ Ft. from S. Line

_____ Ft. from E. Line

990 _____ Ft. from W. Line

Dickinson County

Location _____

Rig up _____

Drilling and Remarks:

10" @ 115

Miss. 2299

2304 TD

7" @ 2304 RUST

RECORD

Cased _____ in., _____ ft.

Sand _____

Gas _____

Oil _____

Total Depth _____

PRODUCTION

1st 24 hrs. Nat. _____

1st 24 hrs. after shot _____

Gas _____ Cu. Ft.

Dry Hole _____

Abandoned _____

Date

FEB 18 1948 19

S. J. LEWIS Scout

