

Map No. 1 Sec. 15 Twp. 16 R. 17

Well No. 1-Pope Farm
General Utility Co. Company

NORTH

WEST

EAST

SOUTH

Location.....

Drilling Remarks

.....

.....

RECORD

Cased..... in..... ft.

Sand.....

Gas.....

Oil.....

Total Depth.....

Rig Up.....

Drilling Remarks

.....

.....

PRODUCTION

1st 24 hrs. Nat.....

1st 24 hrs. after shot.....

Gas..... cu. ft.....

Dry Hole.....

Abandoned.....

Map No. **KANSAS** Sec. 13 Twp. 16 R. 7

Well No. 1 - Pope Farm
General Utility Co. Company


200 Ft. from N. Line

-----Ft. from S. Line

.....Ft. from E. Line

1120 Ft. from W. Line

1928

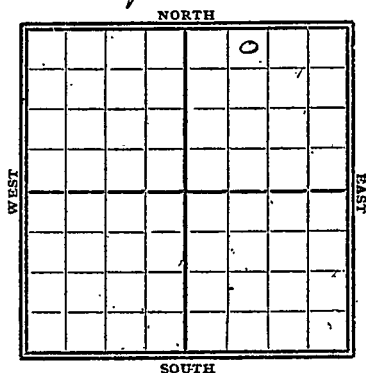

Date _____

REPORT

12/5	Machine
------	---------

12/12 Rgn wp

12/19 dkg 9'00"

12/26 " 1200'

1929

1/2	sand 1450-52'
-----	---------------

TD 1452'

1.4 cu ft gas
Completed

No. 1122 KANSAS

MAP No. _____ SEC. 15 TWP. 16 R. 7

WELL No. 1

Page

Sheraf Utility Co.

COMPANY

FIRST REPORTS

CONTRACTOR

SECTION PLAT

		0	

200 Ft. FROM N. LINE

Ft. FROM S. LINE

Ft. FROM E. LINE

1120 Ft. FROM W. LINE

LOCATION

Machine

RIG UP

DRILLING AND REMARKS:

5 ft

RECORD

CASED _____ IN. _____ FT.

SAND _____

GAS _____

OIL _____

TOTAL DEPTH _____

PRODUCTION

1ST 24 HRS. NAT. _____

1ST 24 HRS. AFTER SHOT _____

GAS _____ CU. FT.

DRY HOLE _____

ABANDONED _____

DATE

DEC 5 1928

CHAS. L. SHERWOOD

192

SCOUT

K27

KANSAS

Map No.

Sec.

15

Twp.

16

R. 7

Well No.

1

Pope

General Utility Co

Company

Contractor

COMPLETED

SECTION PLAT

200

Ft. from N. Line

Ft. from S. Line

Ft. from E. Line

1120

Ft. from W. Line

		0	

Location.....

Rig up.....

Drilling and Remarks:

good well

RECORD

Cased.....in,.....ft.

Sand 1450-1452

Gas.....

Oil.....

Total Depth.....1452

PRODUCTION

1st 24 hrs. Nat.....

1st 24 hrs. after shot.....

Gas..... Cu. Ft.

Dry Hole.....

Abandoned.....

Date

JAN 2

1929

CHAS. L. SHERWOOD

192.....

Scout