



Map No. KANSAS Sec. 15 Twp 16 R. 7E

Well No. 5 Murray Farm  
Home Gas Co Company


\_\_\_\_\_ Ft. from N. Line

760 Ft. from S. Line

330 Ft. from E. Line

\_\_\_\_\_ Ft. from W. Line

1933

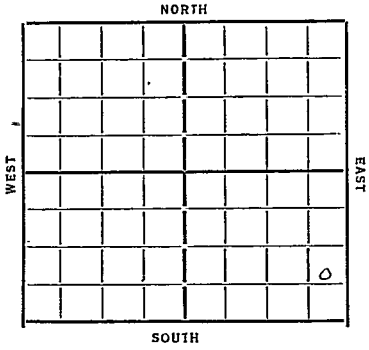

Date

REPORT

1/18

1  
Land 403-422  
TD 422  
1/2 ft gas  
Comp.

*Morris*

27 KANSAS Map No. Sec. 15 Twp. 16 R. 7 <sup>E</sup>

Well No. 5 *Munsel*  
*Home Gas Co* Company

Contractor

FIRST REPORTS  
*and*  
COMPLETED

SECTION PLAT

Ft. from N. Line  
*760* Ft. from S. Line  
*330* Ft. from E. Line  
Ft. from W. Line


Location.....  
Rig up.....  
Drilling and Remarks:

RECORD

Cased.....in., .....ft.  
Sand *403-422*  
Gas.....  
Oil.....  
Total Depth *422*

PRODUCTION

1st 24 hrs. Nat.....  
1st 24 hrs. after shot.....  
Gas *1/2 72* Cu. Ft.  
Dry Hole.....  
Abandoned.....

Date  
JAN 1 8 1933

192 CHAS. L. SHERWOOD Scout