

RELEASED

KANSAS CORPORATION COMMISSION OF KANSAS
MAY 10 1987 GAS CONSERVATION DIVISION
Date: WELL COMPLETION OR RECOMPLETION FORM
FROM CONFIDENTIAL WELL HISTORY
DESCRIPTION OF WELL AND LEASE

SIDE ONE

23-16-166 4/6/86
4-6-87
KCC



API NO. 15-139-20-057
County.. OSAGE
NE... NW. NW. Sec. 23. Twp. 16. Rge. 10... XX East
West

Operator: License # 9803
Name WYKOMA OIL, INC.
Address P.O. BOX 838
City/State/Zip PINE BLUFFS, WY. 82082

.4950..... Ft North from Southeast Corner of Section
.4290..... Ft West from Southeast Corner of Section
(Note: Locate well in section plat below)

CONFIDENTIAL

Purchaser..... none

Lease Name.. WOODWARD..... Well #. 4-23..

Field Name..... none

Operator Contact Person KENNETH D. SPEAR...
Phone 316-721-0572


Producing Formation..... none

Elevation: Ground..... KB... 1094 MSL

Contractor: License # 5101
Name K&W DRILLING

Wellsite Geologist KENNETH D. SPEAR
Phone 316-721-4273

Section Plat

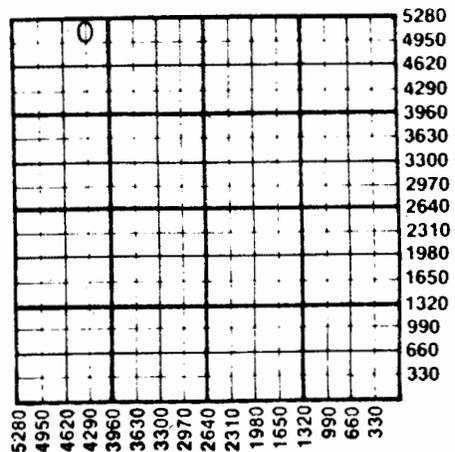

Designate Type of Completion
X New Well Re-Entry Workover

Oil SWD Temp Abd
Gas Inj Delayed Comp.
Dry Other (Core, Water Supply etc.)

XX If ONWO: old well info as follows:
Operator
Well Name
Comp. Date Old Total Depth

WELL HISTORY

Drilling Method:
XX Mud Rotary Air Rotary Cable

.172786... .176786..... .176786.....
Spud Date Date Reached TD Completion Date

..1650.....
Total Depth PBSD

Amount of Surface Pipe Set and Cemented at 52. feet
Multiple Stage Cementing Collar Used? Yes x No
If yes, show depth set.....feet
If alternate 2 completion, cement circulated
from plugged...feet depth to.....w/.....SX cmt
Cement Company Name Consolidated Services
Invoice # 63541

WATER SUPPLY INFORMATION

Disposition of Produced Water: Disposal
Docket # Repressuring

Questions on this portion of the ACO-1 call:
Water Resources Board (913) 296-3717
Source of Water:
Division of Water Resources Permit #.....
Groundwater.....Ft North from Southeast Corner
(Well)Ft West from Southeast Corner of
Sec Twp Rge East West
Surface Water.....Ft North from Southeast Corner
(Stream, pond etc).....Ft West from Southeast Corner
Sec Twp Rge East West
Other (explain).....
(purchased from city, R.W.D. #)

INSTRUCTIONS: This form shall be completed in duplicate and filed with the Kansas Corporation Commission, 200 Colorado Derby Building, Wichita, Kansas 67202, within 90 days after completion or recompletion of any well. Rule 82-3-130 and 82-3-107 apply.
Information on side two of this form will be held confidential for a period of 12 months if requested in writing and submitted with the form. See rule 82-3-107 for confidentiality in excess of 12 months.
One copy of all wireline logs and drillers time log shall be attached with this form. Submit CP-4 form with

SIDE TWO

Operator Name **WYKOMA OIL, INC.** Lease Name **WOODWARD** Well # **4-23**

Sec. **23** Twp. **16** Rge. **16** East West County **OSAGE**

WELL LOG

INSTRUCTIONS: Show important tops and base of formations penetrated. Detail all cores. Report all drill stem tests giving interval tested, time tool open and closed, flowing and shut-in pressures, whether shut-in pressure reached static level, hydrostatic pressures, bottom hole temperature, fluid recovery, and flow rates if gas to surface during test. Attach extra sheet if more space is needed. Attach copy of log.

Drill Stem Tests Taken Yes No
 Samples Sent to Geological Survey Yes No
 Cores Taken Yes No

Formation Description
 Log Sample

Name	Top	Bottom
LANSING	490'	866'
MISSISSIPPIAN	1564'	not reached

CONFIDENTIAL

CASING RECORD <input checked="" type="checkbox"/> New <input type="checkbox"/> Used Report all strings set-conductor, surface, intermediate, production, etc.							
Purpose of String	Size Hole Drilled	Size Casing Set (in O.D.)	Weight Lbs/Ft.	Setting Depth	Type of Cement	#Sacks Used	Type and Percent Additives
surface	9 5/8"	7"	21	52	common	70	2% CaCl
PERFORATION RECORD Shots Per Foot Specify Footage of Each Interval Perforated				Acid, Fracture, Shot, Cement Squeeze Record (Amount and Kind of Material Used) Depth			
none	none			none			
TUBING RECORD none				Size Set At Packer at	Liner Run <input type="checkbox"/> Yes <input checked="" type="checkbox"/> No		