


Map No. KANSAS Sec. 16 Twp. 16 R. 18^E
Well No. Cities Service Farm _____ Company _____

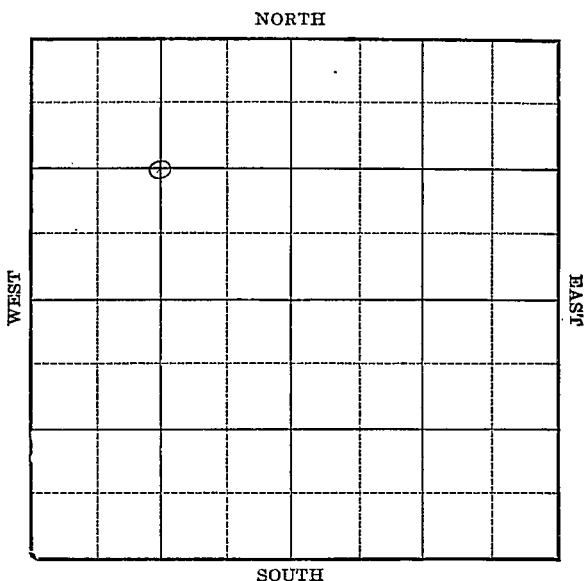

Location _____
Drilling Remarks _____

Rig Up _____
Drilling Remarks _____

RECORD

Cased _____ in. _____ ft.
Sand _____
Gas _____
Oil _____
Total Depth _____

PRODUCTION

1st 24 hrs. Nat. _____
1st 24 hrs. after shot _____
Gas _____ cu. ft. _____
Dry Hole _____
Abandoned _____

Map No. KANSAS Sec. 16 Twp. 16 R. 18^E

Well No. 1- Farm _____

Cities Service Co Company


1320 Ft. from N. Line

_____ Ft. from S. Line

_____ Ft. from E. Line

1320 Ft. from W. Line

1930

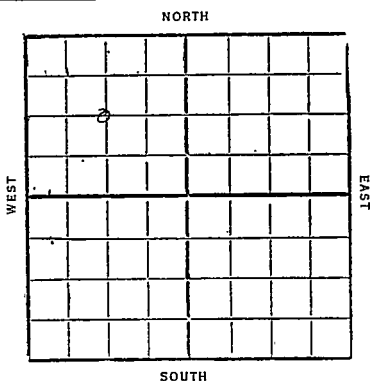

Date

REPORT

12/10

Sand 1117-23

T.D. 1123

3/4 ft gas

365# R.P.

Comp.


Franklin

E

Map No. **KANSAS** Sec. 16 Twp. 16 R. 18Well No. 1Cities Service Co Company**FIRST REPORTS** Contractor**SECTION PLAT**1320 **COMPLETE**
Ft. from N. Line

Ft. from S. Line

Ft. from E. Line

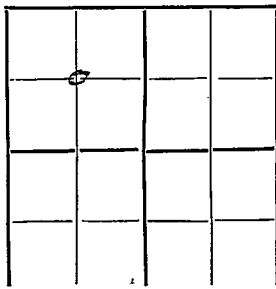1320 Ft. from W. Line

Location

Rig up

Drilling and Remarks:

365 # Rp.

RECORD

Cased in. ft.

Sand 7117-1123

Gas

Oil

Total Depth 1123**PRODUCTION**

1st 24 hrs. Nat.

1st 24 hrs. after shot

Gas 3/4 AA Cu. Ft.

Dry Hole

Abandoned

Date

DEC 10 1930 **CHAS. L. SHERWOOD**
192 Scout