


Map No. **KANSAS** Sec. 16 Twp. 16 R. 17

Well No. 11-Enter Farm

:- Goemish et al Company

NORTH

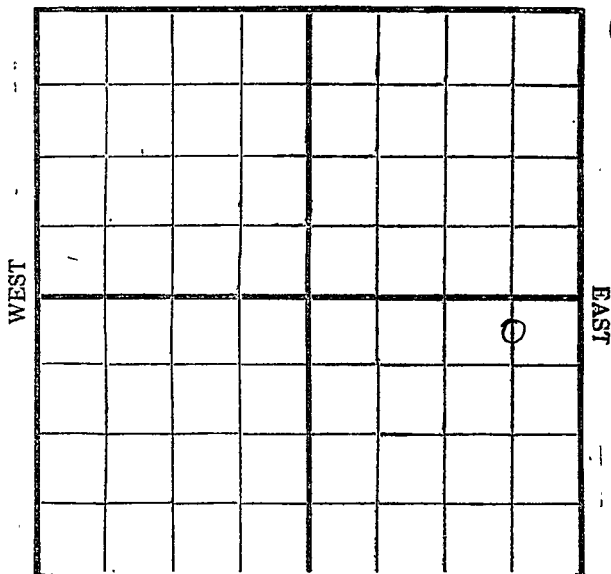

SOUTH

Location _____

Drilling Remarks

Rig Up _____

Drilling Remarks

RECORD

Cased _____ in. _____ ft.

Sand _____

Gas _____

Oil _____

Total Depth_____

PRODUCTION

1st 24 hrs. Nat. _____

1st 24 hrs. after shot_____

Gas_____cu. ft._____

Dry Hole_____.

Abandoned _____

Map No. KANSAS Sec. 16 Twp. 16 R. 7^E

Well No. 1- Jentes Farm


Morris et al Company

330 Ft. from N. Line

 Ft. from S. Line

660 Ft. from E. Line

 Ft. from W. Line

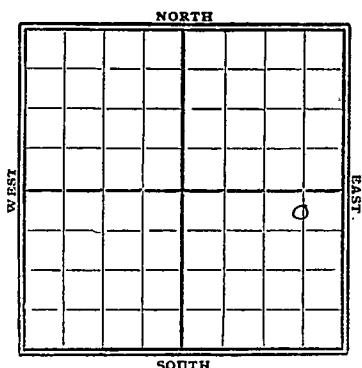

1929

Date

REPORT

8/7	Location
8/14	
8/21	Rig up
8/28	Spd 9 265
9/4	SD 265'
9/11	SD 1475'
9/18	—
9/25	—
10/2	—
10/9	—
10/16	—
10/23	—
10/30	—
11/6	—
11/13	—
11/20	—
11/27	—
12/4	—
12/11	— 1930
12/23	— 1/8 - T.D. 1475'
12/30	— Dry & Abandon
	(over) OUI 17.7

1930 OVIDD
12/23 Old TD 1475
dry 2250'
12/30- SID 2255

1931
1/7 —
1/14 —
1/21 —
1/28 —
2/4 —
2/11 —
2/18 —
2/25 —
3/3 —
3/11 —
3/18 —
3/25 —

3/31- T.D. 2265
dry & Abandon

Morris

27 **KANSAS** Map No. Sec. 16 Twp. 16 R. 7 ^E

Well No. 1 *Jentes*
Loomis Coal Company

Contractor

FIRST REPORTS

330 Ft. from N. Line

_____ Ft. from S. Line

660 Ft. from E. Line

_____ Ft. from W. Line

SECTION PLAT

			0

Location ☒

Rig up

Drilling and Remarks:

RECORD

Cased _____ in., _____ ft.

Sand _____

Gas _____

Oil _____

Total Depth _____

PRODUCTION

1st 24 hrs. Nat. _____

1st 24 hrs. after shot _____

Gas _____ Cu. Ft.

Dry Hole _____

Abandoned _____

Date

AUG 7

1929

CHAS. L. SHERWOOD

192

Scout

no small map

Returned	_____
Cards	_____
Tracing	_____
France Map	_____
Scarborough Map	_____
Moody Map	_____
Scarborough Plat Book	_____
Moody Plat Book	_____

morris

Map No. KANSAS Sec. 16 Twp. 16 R. 7 ^E
 Well No. 27 1 Jentes
Roomis Co et al Company

Contractor

COMPLETE

SECTION PLAT

330 Ft. from N. Line

Ft. from S. Line

660 Ft. from E. Line

Ft. from W. Line

			P

ABANDONED

Location

Rig up

Drilling and Remarks:

RECORD

Cased _____ in., _____ ft.

Sand _____

Gas _____

Oil _____

Total Depth 1475

PRODUCTION

1st 24 hrs. Nat. _____

1st 24 hrs. after shot _____

Gas _____ Cu. Ft.

Dry Hole ☒Abandoned ☒

Date

JAN 8 1930

CHAS. L. SHERWOOD

192 _____ Scout

no answer
wanted

Returned	<i>OTD</i>
Cards	
Tracing	<i>CLX</i>
Francis	<i>JP</i>
Scarborough	<i>P</i>
Moody	
Scarborough	
Moody	

Map No. *27* **KANSAS** Sec. *16* Twp. *16* R. *7* ^E
 Well No. *1* *Jen tes*
Loomis et al Company

Contractor

FIRST REPORTS

330 Ft. from N. Line

Ft. from S. Line

660 Ft. from E. Line

Ft. from W. Line

11

Old well deeper

Location

Rig up

Drilling and Remarks:

*ID was 1475**only 2250'*

SECTION PLAT

			0

RECORD

Cased in, ft.

Sand

Gas

Oil

Total Depth

PRODUCTION

1st 24 hrs. Nat.

1st 24 hrs. after shot

Gas Cu. Ft.

Dry Hole

Abandoned

Date
DEC 23 1930

CHAS. L. SHERWOOD

192

Scout

✓ no
no was
no final
no

Returned	
Cards	
Tracing	
France Map	
Scarborough Map	
Moody Map	
Scarborough Plat Book	
Moody Plat Book	

Morris

E

Map No. **KANSAS** Sec. 16 Twp. 16 R. 7

27

Well No. 1 JentesLoomis & al Company

Contractor

COMPLETE

SECTION PLAT

330 Ft. from N. Line

Ft. from S. Line

660 Ft. from E. Line

Ft. from W. Line

ABANDONED

			0

Location

Rig up

Drilling and Remarks:

RECORD

Cased.....in.,ft.

Sand.....

Gas.....

Oil.....

Total Depth 2265

PRODUCTION

1st 24 hrs. Nat.....

1st 24 hrs. after shot.....

Gas.....Cu. Ft.

Dry Hole: ☒Abandoned: ☒

Date

APR 1 1931 CHAS. L. SHERWOOD

192

Scout

Kind

no maps any
waiting

Returned	_____
Cards	_____
Tracing	_____
France Map	X
Scarborough Map	_____
Moody Map	X
Scarborough Plat Book	_____
Moody Plat Book	_____