


KANSAS Morris

FORM 51 5M 11-44 PETROL

Section 18 Township 16 Range 5-E

Well No. #1 Kind Kind

Company W.E. Harding

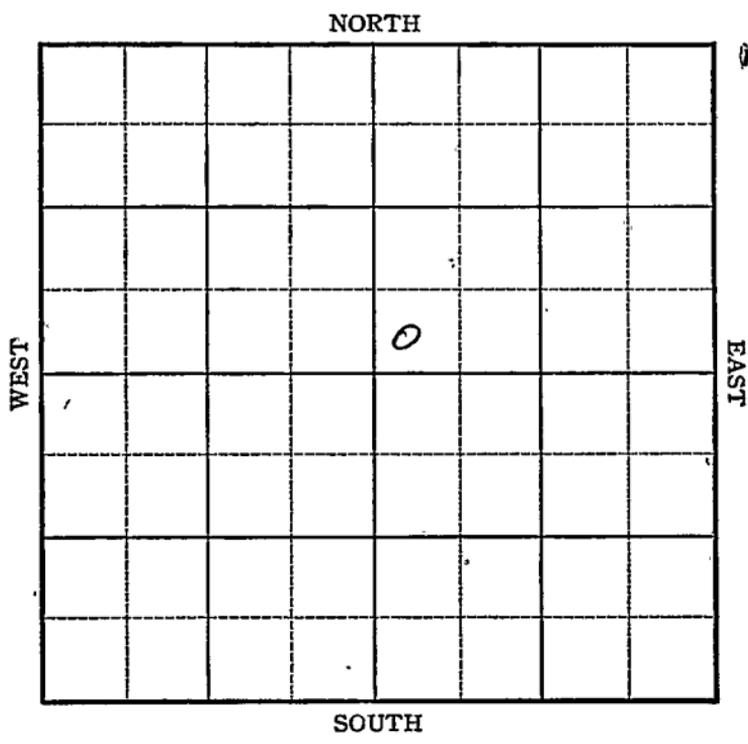

Sec. 18 Twp. 16 R. 5-E

Well No. #1 Kind Farm


W. E. Harding Company

         Ft. from N. Line

330 Ft. from S. Line

         Ft. from E. Line

330 Ft. from W. Line

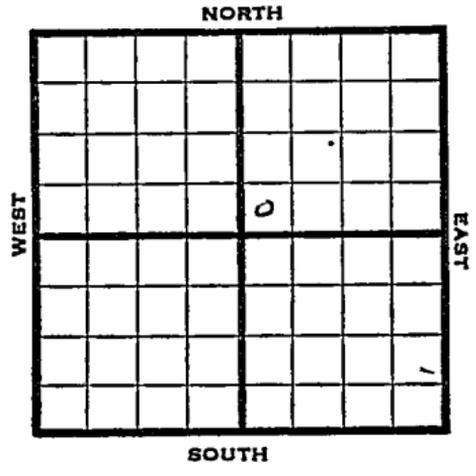

SW NE

1945 Elev. ~~2278~~ REPORT

- 12/5 Spud
- 12/12 8" @ 130 WOC
- 12/20 " "
- 12/29 Drlg. 925'
- 1946
- 1/10 Miss. 2253-61' T.D.  
5" - 2253' WOC.
- 1/17 " " "
- 1/24. Drlg. 2266' SSO.
- 1/30 Miss. 2253  
5" @ 2278  
TD 2278' HFW

**ABANDONED**

KANSAS

Pool Name WildcatMap No. K-26 Sec. 18 Twp. 16 R. 5EWell No. 1 Kind \_\_\_\_\_W. E. Harding

Company

FIRST REPORT

Contractor

SW NE

SECTION PLAT

\_\_\_\_\_ Ft. from N. Line

330 Ft. from S. Line

\_\_\_\_\_ Ft. from E. Line

330 Ft. from W. Line


Morris

Location \_\_\_\_\_

Rig up \_\_\_\_\_

Drilling and Remarks:

spud

## RECORD

Cased        in.,        ft.Sand       Gas       Oil       Total Depth       

## PRODUCTION

1st 24 hrs. Nat.       1st 24 hrs. after shot       Gas        Cu. Ft.Dry Hole       Abandoned       

Date

DEC 5 194519S. J. LEWIS Scout

