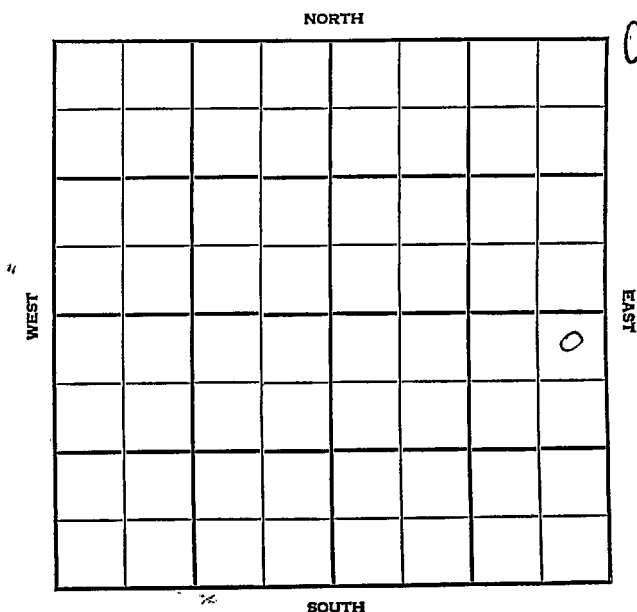


Section 18 Township 16 S Range 4 EWell No. #1 PetersCompany John Gerhke

Dickerson

KANSAS

SEC.	TWP.	R..
18	16S	4E

WELL NO.

#1 Peters

FARM

COMPANY

John Gerhke

CONTRACTOR

Slusser


Wildcat

_____ Ft. from N. Line

_____ Ft. from S. Line

_____ Ft. from E. Line

_____ Ft. from W. Line

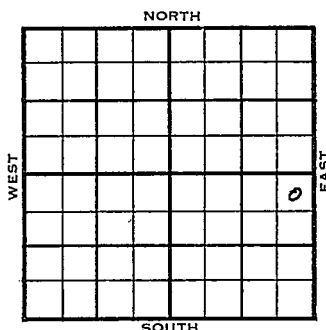

NE NE SE

Sam Pack - DHM Daetwiler FO

	ELEVATION	REPORT
1955	1382	

9/21

Loc.

~~8/21~~

10/12

Comm 10-2-55

8 5/8" @ 110/90

DG 1575

L 1675

Chert 2276

M 2321

TD 2351

8 5/8" @ 110/90 D & A

ABANDONED

2276
1382
-894

*No County*County Dickinson

Elev. _____

Sec. 18Twp. 16SRge. 4ECompany John GerhkeFarm Name PetersNo. 1

TOPS

DEPTH

LOG

DATUM

Loc. in Sec. _____

Anh. _____

NE NE SE

Tp. _____

H. _____

Sam Pack-DHM

Tr. _____

Dg. _____

Daetwiler-FO

BL. _____

L. _____

K.C. _____

Geol. _____

B.K.C. _____

Ce. _____

Contr. _____

C. _____

Slusser

M. _____

M. _____

Pool _____

K. _____

Wildcat

Mz. _____

Me. _____

V. _____

S. _____

FIRST REPORT

S. _____

A. _____

R. _____

PE. _____

G. _____

T.D. _____

Date Comm. _____

SEP 28 1955

Loc. _____

Co.

Lse.

No.

Sec.

T.

R.

No County

County Dickinson Elev. 1382Sec. 18 Twp. 16 Rge. 4ECompany John GerhkeFarm Name Peters No. 1

TOPS	DEPTH	LOG	DATUM	Loc. in Sec.
Anh.				NE NE SE
Tr.				
H.				
Tr.				
Dg.	<u>1574</u>		<u>192</u>	
Bl.				
L.	<u>1675</u>		<u>293</u>	Geol.
K.C.				Contr.
B.K.C.				
Ce.				
C. <u>Chert</u>	<u>2276</u>		<u>894</u>	<u>Slusser</u>
M.	<u>2321</u>		<u>939</u>	
M.				Pool
K.				<u>Wildcat</u>
Mz.				
Mq.				
V.				
S.				
S.				
A.				
R.				
PE.				
G.				
T.D.	<u>2351</u>			

ABANDONED

Date Comm. KO-2-55 OCT 12 1955

8 5/8" @ 110/90.

D & A