


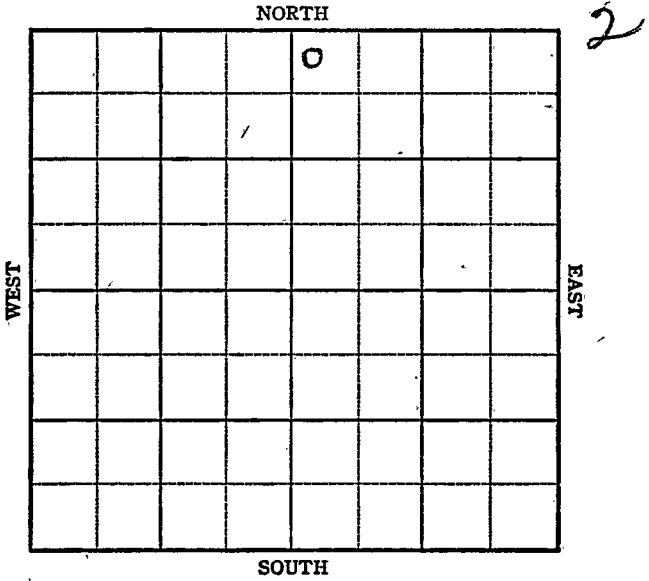

Section 19 Township 16 Range 6-E

Well No. # 1 Kerteneach

Company Brazil & Newton et al





Sec. 19 Twp. 16 R. 6-E

Well No. #1 Kerteneach Farm

Brazil & Newton etal Company


No Name

330 Ft. from N. Line

Ft. from S. Line

Ft. from E. Line

330 Ft. from W. Line

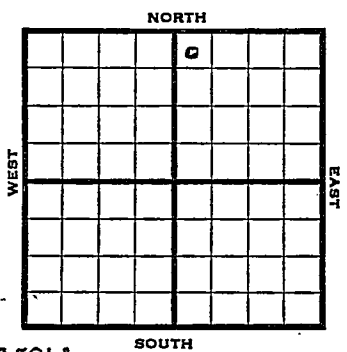

NW NE Elev. Est. 1504'

REPORT

1947

3/12 Location

3/18 "

3/25 "

4/2 Rig

4/9 Drlg 200'

4/15 8" @ 165'
Drlg. 800'

4/23 1815 fsg

4/29 " "

5/7 Viola 2498
Drlg 2680'

5/13 Simpson Sands 2799'-2800' TD
5" @ 2800'
RUST

5/20 TD 2820' HFW
PB 2580'

OVER

5/28

Simp sd
5" @ 2800'
TD 2820'

ABANDONED

Kansas KANSAS

Map No. K 26 Sec. 19 Twp. 16 R. 6EWell No. 1 KerteneachBrázil & Newton etal. Company**ABANDONED**

Contractor

NW NE

E. 1504
SECTION PLAT330 Ft. from N. Line

_____ Ft. from S. Line

_____ Ft. from E. Line

330 Ft. from W. Line

		o	

Morris County

Location _____

Rig up _____

Drilling and Remarks:

*Sample Sec 12999
5" @ 2700*

RECORD

Cased _____ in., _____ ft.

Sand _____

Gas _____

Oil _____

Total Depth 2900

PRODUCTION

1st 24 hrs. Nat. _____

1st 24 hrs. after shot _____

Gas _____ Cu. Ft.

Dry Hole _____

Abandoned _____

Date

MAY 28 1947 19 S. J. LEWIS Scout

no mail

Misc Small Maps	<input checked="" type="checkbox"/>
Cards	<input checked="" type="checkbox"/>
Tracing	<input checked="" type="checkbox"/>
France Map	<input checked="" type="checkbox"/>
Scarborough M.	<input checked="" type="checkbox"/>
Pierce Map	<input checked="" type="checkbox"/>
Geological Dept.	<input type="checkbox"/>
Pierce Plat Book	<input type="checkbox"/>

KANSAS

No Name

Map No. 26 Sec. 19 Twp. 16 R. 6EWell No. 1 KerteneachBrazil & Newton etal. CompanyFIRST REPORT Contractor

NW NE

SECTION PLAT

330 Ft. from N. Line Ft. from S. Line Ft. from E. Line330 Ft. from W. Line

		o	

Morris CountyLocation XRig up

Drilling and Remarks:

RECORD

Cased in., ft.Sand Gas Oil Total Depth

PRODUCTION

1st 24 hrs. Nat. 1st 24 hrs. after shot Gas Cu. Ft.Dry Hole Abandoned

Date

MAR 1 2 1947 19S. J. LEWIS Scout

