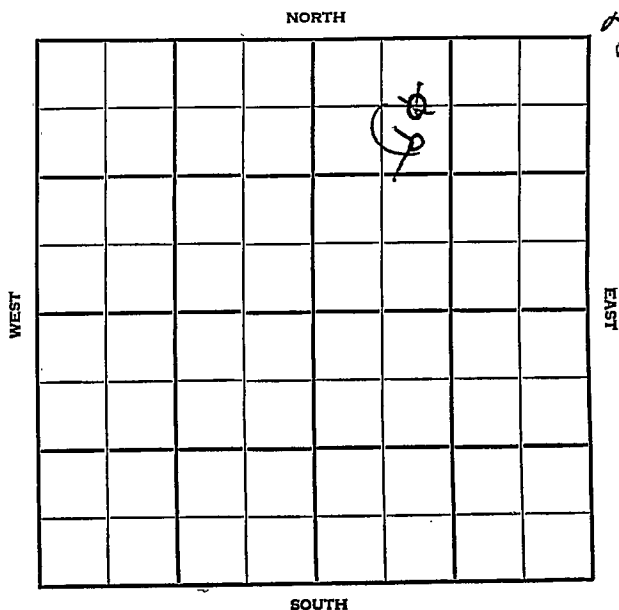


Section 19 Township 16 Range 5 EWell No. # 1 FloydCompany Slusser et al

Morris KANSAS

SEC.	TWP.	R.
19	16	5E

WELL NO. _____

I Floyd FARM

COMPANY _____

Slusser et al

CONTRACTOR _____


Wildcat

~~990~~ ~~660~~ _____ Ft. from N. Line

_____ Ft. from S. Line

_____ Ft. from E. Line

990 _____ Ft. from W. Line

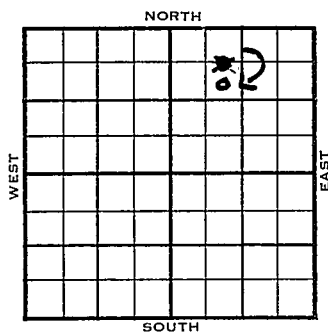

SE NW NE
~~SE E/2 NW NE~~

1955	ELEVATION 1396'	REPORT
------	---------------------------	--------

3/16 Spud 3-11-55
8" @ 108'
Drlg. 1725'

4/20 Spud 3-11-55
D & A
TD 2282'
8" @ 108'
Miss 2250'
TD 2253'
5" @ 2253'
E DD 2282'
HFW
D & A

ABANDONED

SCOUT TICKET

DX-201

Kansas

SEC.

19

TWP.

16

R.

5E

WELL NO.

1 Floyd

FA

COMPANY

Slusser

CONTRACTOR

CORRECTION

SE NW NE

990

FT. FROM N. LINE


FT. FROM S. LINE

FT. FORM E. LINE

990

FT. FROM W. LINE

NORTH

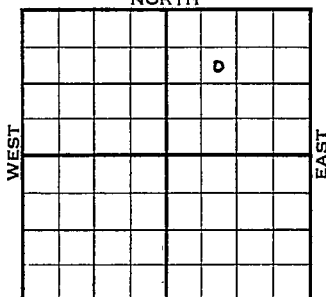

SOUTH

Morris County

☐

LOCATION

☐

RIG UP

DRILLING AND REMARKS:

Reported

C₁ E_{1/2} NW NE

RECORD

CASED IN., FT.

SAND

GAS

OIL

TOTAL DEPTH

1ST 24 HRS. NAT.

1ST 24 HRS. AFTER SHOT

GAS CU. FT.

DRY HOLE

ABANDONED


PRODUCTION

DATE

MAR 30 1955

SCOUT

FABEN GILSTRAP

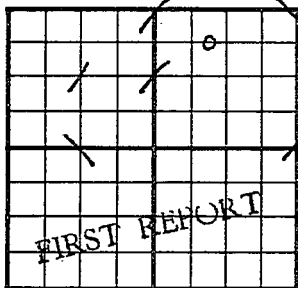
County Morris State KansasSec. 19 (Blk.
Twp.) 16 (Sur.
Rge.) 5E Map No.Operator Slusser et al.Well No. 1 Farm FloydElev. Location C E $\frac{1}{2}$ NW NE660 Ft. From N Line NE990 Ft. From N Line Quarter1st. Report MAR 16 1955

Completion

Remarks

Spudding Date 3-11-55Drlg. Data Wildcat8" @ 108 drlg. 1725

FABEN GILSTRAP

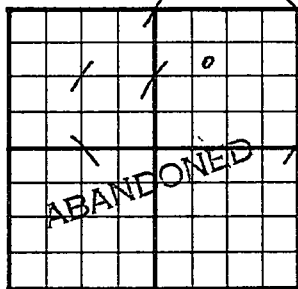County Morris State KansasSec. 19 (Blk.) 16 (Sur.) 5E Map No.Operator Slusser etal.Well No. 1 Farm FloydElev. 1396 Location SE NW NE990 Ft. From N Line NE990 Ft. From W Line Quarter

1st. Report

Completion APR 20 1955Remarks WildcatSpudding Date 3-11-55Drlg. Data D & A TD 22828" @ 108 Miss. 2250 TD 22535" @ 2253 DD 2282 HFWD & A

FABEN GILSTRAP