


Map No. **KANSAS** Sec. 12 Twp. 16 R. 2<sup>E</sup>  
Well No. 1- Rumold Farm  
Prairie O & S Company

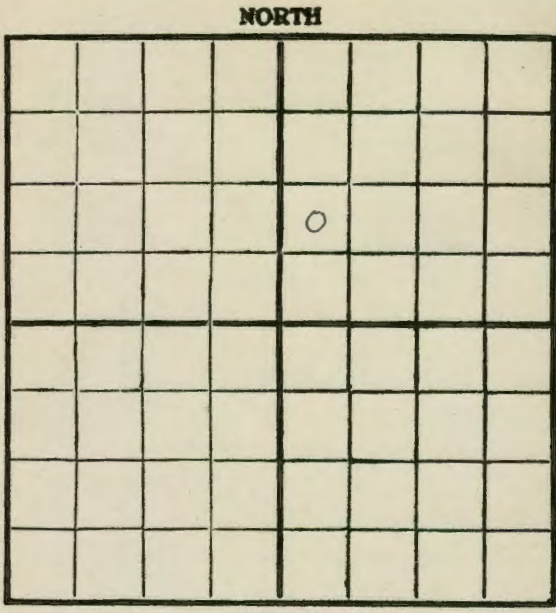

Location \_\_\_\_\_  
Drilling Remarks \_\_\_\_\_  
\_\_\_\_\_  
\_\_\_\_\_  
\_\_\_\_\_  
\_\_\_\_\_  
\_\_\_\_\_  
\_\_\_\_\_  
\_\_\_\_\_  
\_\_\_\_\_  
\_\_\_\_\_


Rig Up \_\_\_\_\_  
Drilling Remarks \_\_\_\_\_  
\_\_\_\_\_  
\_\_\_\_\_  
\_\_\_\_\_  
\_\_\_\_\_  
\_\_\_\_\_  
\_\_\_\_\_  
\_\_\_\_\_  
\_\_\_\_\_  
\_\_\_\_\_

**RECORD**  
Cased \_\_\_\_\_ in. \_\_\_\_\_ ft.  
Sand \_\_\_\_\_  
Gas \_\_\_\_\_  
Oil \_\_\_\_\_  
Total Depth \_\_\_\_\_

**PRODUCTION**  
1st 24 hrs. Nat. \_\_\_\_\_  
1st 24 hrs. after shot \_\_\_\_\_  
Gas \_\_\_\_\_ cu. ft. \_\_\_\_\_  
Dry Hole \_\_\_\_\_  
Abandoned \_\_\_\_\_

Map No. **KANSAS** Sec. 12 Twp. 16 R. 2<sup>E</sup>  
Well No. 1- Rumold Farm  
Prairie O & S Company

1650 Ft. from N. Line  
\_\_\_\_\_ Ft. from S. Line  
\_\_\_\_\_ Ft. from E. Line  
330 Ft. from W. Line

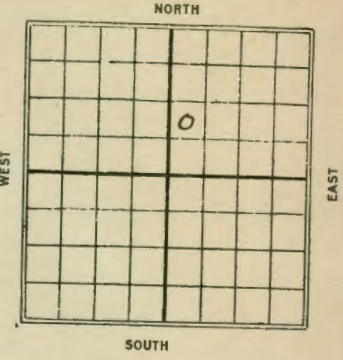

Date	REPORT
10/30	Location
11/6	
11/13	
11/20	Rig
11/27	Ran up
12/4	Shd.
12/11	Dry 800'
12/23	" 1400'
12/30	" 1470'
1930	
1/7	" 1790'
1/15	" 1870'
1/22	Log 2080'
1/29	Dry 2235'
2/4	" 2360
2/11	Top Chat 2410 - show oil, gas & H <sub>2</sub> O - 2410-2415 - Dry 2590
2/19	Base line 2590 6" 2681 - H <sub>2</sub> O - 2683 in line
2/26	dry 2935'

3/5- Delq. 3040'

3/12- " 3143'

3/19- " 3200'

3/26- Top Chat 2410'

show oil & gas  
from 24-10-15'

Base line 2590

sand 2995-3010-HFW

T.D. 3205'

Dry & Abandon

Dickinson

Map No. <sup>25</sup> KANSAS Sec. 12 Twp. 16 R. 2 E

Well No. 1 Remold

Prairie Oil & Gas Company

Contractor

FIRST REPORTS

SECTION PLAT

1650 Ft. from N. Line

Ft. from S. Line

Ft. from E. Line

330 Ft. from W. Line

		0	

Location ✓

Rig up

Drilling and Remarks:

RECORD

Cased.....in., .....ft.

Sand.....

Gas.....

Oil.....

Total Depth.....

PRODUCTION

1st 24 hrs. Nat.....

1st 24 hrs. after shot.....

Gas.....Cu. Ft.

Dry Hole.....

Abandoned.....

Date

OCT 30 1929 CHAS. L. SHERWOOD

192 Scout

Dickinson

Map No. <sup>25</sup> KANSAS Sec. 12 Twp. 16 R. 2 E

Well No. 1 Remold

Prairie Oil & Gas Company

Contractor

COMPLETE

SECTION PLAT

1650 Ft. from N. Line

Ft. from S. Line

Ft. from E. Line

330 Ft. from W. Line

		0	

Location

Rig up

Drilling and Remarks:

tap chat 2410 show into gas. 2410-2415

Beas line 7590'

Sand 2995-3010 HFV

RECORD

Cased.....in., .....ft.

Sand.....

Gas.....

Oil.....

Total Depth 3205

PRODUCTION

1st 24 hrs. Nat.....

1st 24 hrs. after shot.....

Gas.....Cu. Ft.

Dry Hole.....

Abandoned.....

Date

MAR 26 1930 CHAS. L. SHERWOOD

192 Scout