


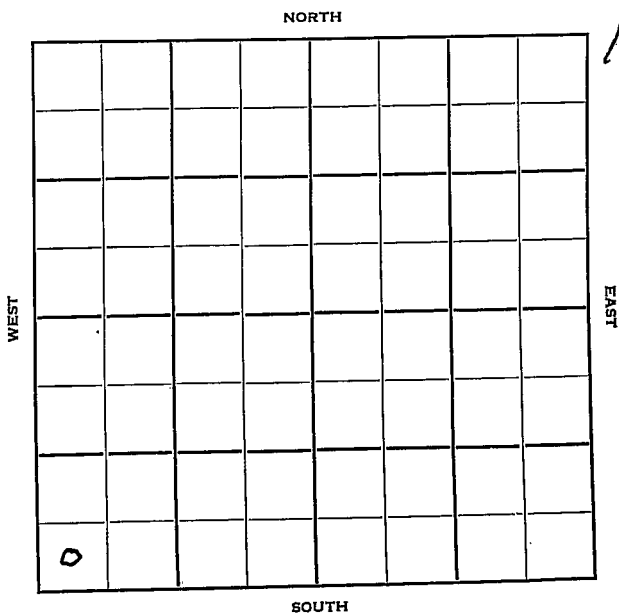

Section 2 Township 16 Range 7E

Well No. #1 Alexander

Company C.W. Brakensiek



13

Sec. 2 Twp. 16 R. 7E

Well No. #1 Alexander Farm

C. W. Brakensiek Company

Wildcat


_____ Ft. from N. Line

330' Ft. from S. Line

_____ Ft. from E. Line

330' Ft. from W. Line

SW SW SW

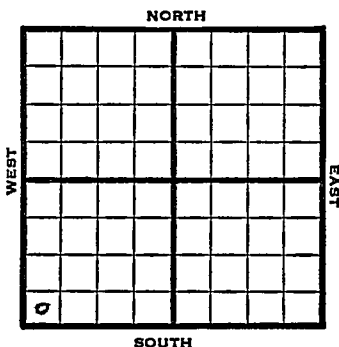

1950

REPORT

1/11 Spud 12-31-49
6-5/8" @ 202'
Drlg. 370'

1/18 TD 630'
6 5/8" @ 202
TD 630 in Indian Cave sand
D&A
Aband.

ABANDONED

Kansas

Wildcat

Map No. _____ Sec. 2 Twp. 16 R. 7EWell No. 1 Alexander

_____ C. W. Brakensiek _____ Company

_____ Contractor

SW SW SW

SECTION PLAT

FIRST REPORT			
o			

_____ Ft. from N. Line

330 Ft. from S. Line

_____ Ft. from E. Line

330 Ft. from W. Line

Morris County

Location _____

Rig up _____

Drilling and Remarks:

Spud 12-31-496 5/8" @ 202drlg. 370

RECORD

Cased _____ in., _____ ft.

Sand _____

Gas _____

Oil _____

Total Depth _____

PRODUCTION

1st 24 hrs. Nat. _____

1st 24 hrs. after shot _____

Gas _____ Cu. Ft.

Dry Hole _____

Abandoned _____

Date

JAN 11 1950 19J. E. TYRA Scout

Kansas

Map No. _____ Sec. 2 Twp. 16 R. 7E

Well No. 1 Alexander

C. W. Brakensiek Company

Contractor

SW SW SW

SECTION PLAT

ABANDONED		
o		

_____ Ft. from N. Line

330 Ft. from S. Line

_____ Ft. from E. Line

330 Ft. from W. Line

Morris County

Location _____

Rig up _____

Drilling and Remarks:

6 5/8" @ 202

*T.D. 630 in
Indian Cave
sand*

D + A.

RECORD

Cased _____ in., _____ ft.

Sand _____

Gas _____

Oil _____

Total-Depth 630

PRODUCTION

1st 24 hrs. Nat. _____

1st 24 hrs. after shot _____

Gas _____ Cu. Ft.

Dry-Hole _____

Abandoned _____

Date

JAN 18 1950

19

J. E. TYRA

Scout