

STATE CORPORATION COMMISSION OF KANSAS OIL & GAS CONSERVATION DIVISION

WELL COMPLETION OR RECOMPLETION FORM ACO-1 WELL HISTORY

DESCRIPTION OF WELL AND LEASE

Operator: license # 9607
name Painter Oil Company, Inc.
address 9865 Fairwood Lane
City/State/Zip Memphis, TN 38119

Operator Contact Person James L. Mietchen
Phone (913) 242-2700

Driller: license # 6807
name Oil Drillers & Developers, Inc.

Site Geologist NONE
Phone
HASER NONE

Well Type of Completion

☒ New Well ☐ Re-Entry ☐ Workover

☒ Oil ☐ SWD ☐ Temp Abd
☐ Gas ☐ Inj ☐ Delayed Comp.
☐ Dry ☐ Other (Core, Water Supply etc.)

WWO: old well info as follows:

Operator
Well Name
Comp. Date Old Total Depth

WELL HISTORY

Drilling Method: ☒ Mud Rotary ☐ Air Rotary ☐ Cable

7/11/84 7/11/84
Date Date Reached TD Completion Date

800' PBDT

Depth of Surface Pipe Set and Cemented at 42 feet

Multiple Stage Cementing Collar Used? ☐ Yes ☒ No

If Yes, Show Depth Set feet

Alternate 2 completion, cement circulated

feet depth to w/ SX cmt

API NO. 15 - 059-23,593

County Franklin

NW 1/4 Sec 4 Twp 16 Rge 20

2805 Ft North from Southeast Corner of Section
3795 Ft West from Southeast Corner of Section
(Note: locate well in section plat below)


Lease Name Stecker Well# 1

Field Name Wildcat

Producing Formation NONE

Elevation: Ground KB

Section Plat

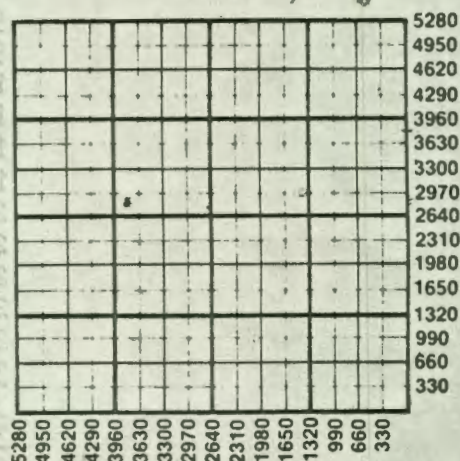

WATER SUPPLY INFORMATION

Source of Water:

Division of Water Resources Permit #

☐ Groundwater. Ft North From Southeast Corner and (Well) Ft. West From Southeast Corner of

Sec Twp Rge ☐ East ☐ West

☐ Surface Water. Ft North From Southeast Corner and (Stream, Pond etc.) Ft West From Southeast Corner

Sec Twp Rge ☐ East ☐ West

☐ Other (explain) (purchased from city, R.W.D.#)

Disposition of Produced Water: ☐ Disposal ☐ Repressuring

Docket #

INSTRUCTIONS: This form shall be completed in duplicate and filed with the Kansas Corporation Commission, 200 Colorado Derby Building, Topeka, Kansas 67202, within 90 days after completion or recompletion of any well. Rules 82-3-130 and 82-3-107 apply.

Information on side two of this form will be held confidential for a period of 12 months if requested in writing and submitted with the form. See rule 82-3-107 confidentiality in excess of 12 months.

Copy of all wireline logs and driller's time log shall be attached to this form.

STATE CORPORATION COMMISSION RECEIVED

Operator Name Painter Oil Company, Inc. Case Name Stecker Well# 1 SEC 4 TWP 16 RGE 20

WELL LOG

INSTRUCTIONS: Show important tops and base of formations penetrated. Detail all cores. Report all drill stem test giving interval tested, time tool open and closed, flowing and shut-in pressures, whether shut-in pressure reached level, hydrostatic pressures, bottom hole temperature, fluid recovery, and flow rates if gas to surface during test. At extra sheet if more space is needed. Attach copy of log.

Drill Stem Tests Taken

☐ Yes☐ No

Samples Sent to Geological Survey

☐ Yes☐ No

Cores Taken

☐ Yes☐ No

Formation Description

☐ Log☐ Sample

Topsoil & Clay

	0	40
Shale	40	51
Lime	51	57
Shale	57	59
Lime	59	76
Shale	76	82
Lime	82	94
Shale	94	98
Lime	98	118
Shale	118	145
Lime	145	170
Shale	170	176
Lime	176	200
Shale	200	251
Lime	251	271
Shale	271	292
Lime	292	296
Shale	296	329
Lime	329	340
Shale	340	345
Lime	345	348
Shale	348	362
Lime	362	377
Shale	377	381
Lime	381	388
Shale	388	395
Lime	395	420
Shale	420	425
Lime	425	429
Shale	429	431
Lime	431	441
Shale	441	483
Gas Sand & Shale	483	500

Name

Top

Bottom

Shale	500	60
Lime	606	61
Black & Gray Shale	615	
Lime	637	
Shale	640	6
Lime	658	6
Black Shale	661	6
Shale	667	
Lime	670	
Shale	673	6
Lime	680	6
Shale	683	6
Lime	685	6
Sandy Shale	698	7
Shale	701	7
Sandy Shale	705	7
Shale	706	7
Sandy Shale	714	7
Shale	716	7

CASING RECORD

☐ new☐ used

Report all strings set - conductor, surface, intermediate, production, etc.

Purpose of string	size hole drilled	size casing set (In O.D.)	weight lbs/ft.	setting depth	type of cement	# sacks used	type and percent additives
surface		6 1/4"		42'	portland		2% Gel

PERFORATION RECORD

shots per foot

specify footage of each interval perforated

Acid, Fracture, Shot, Cement Squeeze Record

(amount and kind of material used)

Depth

shots per foot	specify footage of each interval perforated	(amount and kind of material used)	Depth