

STATE CORPORATION COMMISSION OF KANSAS
OIL & GAS CONSERVATION DIVISION
WELL COMPLETION OR RECOMPLETION FORM
ACO-1 WELL HISTORY
DESCRIPTION OF WELL AND LEASE

Operator: License # 4441
Name Reusch Well Service, Inc.
Address 401 S. Main, Suite 11
City/State/Zip Ottawa, KS 66067

Purchaser N/A

Operator Contact Person Robert Reusch
Phone 913-242-5733

Contractor: License # 4441
Name Reusch Well Service, Inc.

Wellsite Geologist None
Phone

Designate Type of Completion
 New Well Re-Entry Workover
 OTT SWD Temp Abd
 Gas Inj Delayed Comp.
 Dry Other (Core, Water Supply etc.)

If ONWO: old well info as follows:
Operator
Well Name
Comp. Date Old Total Depth

WELL HISTORY

Drilling Method:
 Mud Rotary Air Rotary Cable
3/31/87... 4/8/87... 4/8/87...
Spud Date Date Reached TD Completion Date
812... N/A...
Total Depth PBTD
Amount of Surface Pipe Set and Cemented at 21 feet
Multiple Stage Cementing Collar Used? Yes No
If yes, show depth set... feet
If alternate 2 completion, cement circulated
from 21 feet depth to top w/.5 SX cmt
Cement Company Name Reusch Well Service
Invoice # N/A

API NO. 15-059-24,214
County Franklin
NE. NE. SW Sec. 29 Twp 26 Rge 30 East West

2485 Ft North from Southeast Corner of Section
2650 Ft West from Southeast Corner of Section
(Note: Locate well in section plat below)


Lease Name Keith Well # 1

Field Name Wellsville

Producing Formation none

Elevation: Ground unknown KB

Section Plat

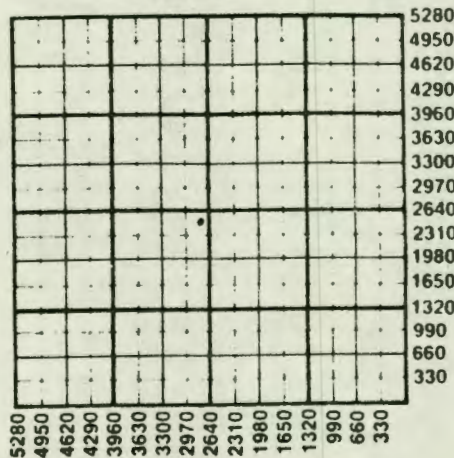

KANSAS GEOLOGICAL SURVEY
WICHITA BRANCH
JUN 02 1987

WATER SUPPLY INFORMATION

Disposition of Produced Water: N/A Disposal
Docket # Repressuring

Questions on this portion of the ACO-1 call:

Water Resources Board (913) 296-3717
Source of Water: N/A
Division of Water Resources Permit #
Groundwater...Ft North from Southeast Corner
(Well) ...Ft West from Southeast Corner of
Sec Twp Rge East West
Surface Water...Ft North from Southeast Corner
(Stream, pond etc)...Ft West from Southeast Corner
Sec Twp Rge East West
Other (explain) (purchased from city, R.W.D. #)

INSTRUCTIONS: This form shall be completed in triplicate and filed with the Kansas Corporation Commission, 200 Colorado Derby Building, Wichita, Kansas 67202, within 120 days of the spud date of any well. Rule 82-3-130, 82-3-107 and 82-3-106 apply.

Information on side two of this form will be held confidential for a period of 12 months if requested in writing and submitted with the form. See rule 82-3-107 for confidentiality in excess of 12 months. One copy of all wireline logs and drillers time log shall be attached with this form. Submit CP-4 form with all plugged wells. Submit CP-111 form with all temporarily abandoned wells.

SIDE TWO

Operator Name Reusch Well Service, Inc. Lease Name Keith Well # 1

Sec. 10 Twp. 16 Rge. 20 East West County Franklin

WELL LOG

INSTRUCTIONS: Show important tops and base of formations penetrated. Detail all cores. Report all drill stem tests giving interval tested, time tool open and closed, flowing and shut-in pressures, whether shut-in pressure reached static level, hydrostatic pressures, bottom hole temperature, fluid recovery, and flow rates if gas to surface during test. Attach extra sheet if more space is needed. Attach copy of log.

Drill Stem Tests Taken Yes No
 Samples Sent to Geological Survey Yes No
 Cores Taken Yes No

Formation Description
 Log Sample

Name	Top	Bottom
Soil & Clay	12	
Lime	19	
Shale	21	
Lime	39	
Shale	47	
Lime	57	
Shale	65	
Lime	98	
Shale	106	
Lime	116	
Shale	146	
Lime	157	
Shale	204	
Lime	228	
Shale	241	
Lime	254	
Shale	277	
Lime	293	
Shale	297	
Lime	299	
Shale	314	

Name	Top	Bottom
Shale	631	
Lime	638	
Shale	642	
Sand	644	
Shale	692	
Lime	695	
Shale	696	
Sand	700	
Shale	738	
Lime	739	
Sand	740	
Shale	752	
Red Bed	755	
Shale	763	
Sand	765	
Slate	768	
Shale	812	

CASING RECORD New Used

Report all strings set-conductor, surface, intermediate, production, etc.

Purpose of String	Size Hole Drilled	Size Casing Set (In O.D.)	Weight Lbs/Ft.	Setting Depth	Type of Cement	#Sacks Used	Type and Percent Additives
Surface	9"	6 1/4"		21	Portland	5	
.....
.....
.....

PERFORATION RECORD

Acid, Fracture, Shot, Cement Squeeze Record

Shots Per Foot	Specify Footage of Each Interval Perforated	(Amount and Kind of Material Used)	Depth
.....
.....
.....
.....

TUBING RECORD Size Set At Packer at Liner Run Yes No

Date of First Production Producing Method
 dry hole Flowing Pumping Gas Lift Other (explain).....