

Morris

KANSAS

20

16S

8E


SECTION _____ TOWNSHIP _____ RANGE _____

#1 Wilson

WELL NO. _____

White & Ellis

COMPANY _____

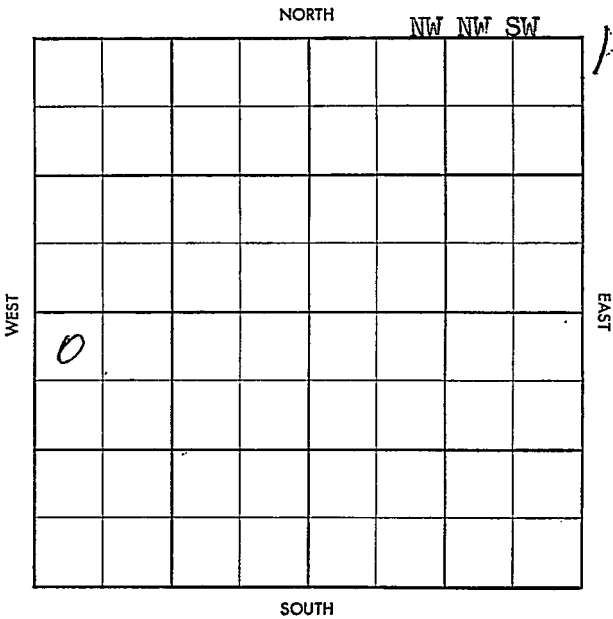

First
Camp

11
1980
1380
/5

FORM 513 SUNRAY

(No County Map)

County Lorris Elev. 1350 DF
 Sec. 20 Twp. 16 Rge. 81
 Company White & Ellis
 FarmName Wilson No. 1

TOPS	DEPTH	LOG	DATUM
Anh.			
TP.			
H.			
Tr.			
Dg.			
BL.			
L.	1616		
K.C.	1729		
B.K.C.	1980		
Ce.			
C.			
M.	2482		
M.		2867	
K.	2719	2482	
Mz. <u>Hunt</u>	2867	295	
Ma.	2934		
V.	3009		
S. <u>sh</u>	3082		
S. <u>sd</u>	3104		
A.	3181		
R.			
PE.			
G.			
T.D.	3226		

Loc. in Sec. NE 1/4 SW
 Geol. _____
 Contr. _____
 Pool _____
ABANDONED
 JUN 26 57

Date Comm. Phillips - DR.
 M I R T - E 5' 8" & 18' 125 JUN 11 57

Ø 2000 DST 2868-76 w/ 30" rev 1288' salt wtr
 FP 10-667 BHP 920/20
 DST 3011-19 w/ 90" rev 100'
 Ø Md + 95' SW 1050/20"
 DST 5+PK/ 3102-12 w/ 1hr
 rev 3' ocm + 180' MW BHP
 1035/20" D. J. Q.