


Section 20 Township 16 Range 4 E

Well No. #2 Kandt

Company Augusta Oil

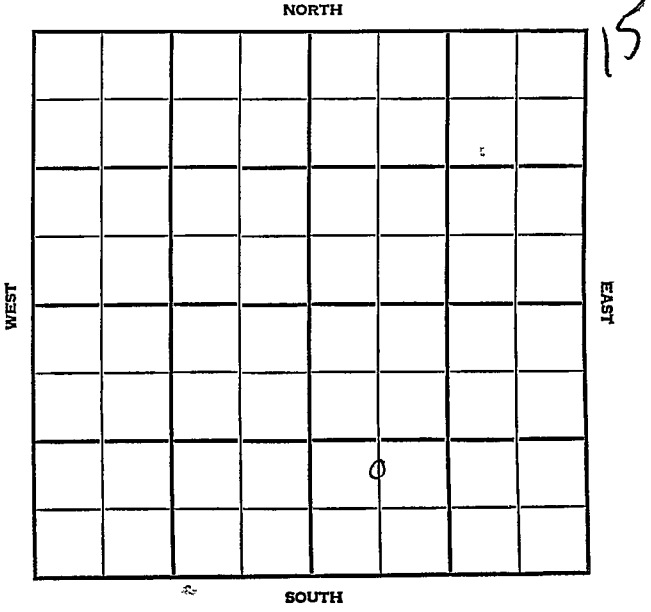

Dickinson

KANSAS

| | | |
|------|------|----|
| SEC. | TWP. | R. |
| -20 | 16 | 1E |

WELL NO. #2 **Kandt** FARM COMPANY

Augusta Oil CONTRACTOR


Co. Tools
NW Lost Springs

_____ Ft. from N. Line

_____ Ft. from S. Line

_____ Ft. from E. Line

_____ Ft. from W. Line

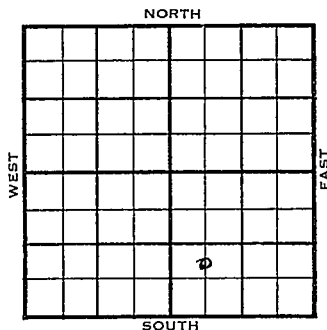

C N $\frac{1}{2}$ SW SE

| | | |
|------|-----------|----------------------------|
| 1955 | ELEVATION | REPORT FIRST REPORT |
|------|-----------|----------------------------|

8/10 Comm: 8-7-55
8" @86/70 Drlg: 389

9-14 4 $\frac{1}{2}$ " @ 2267 DD 2271
S/ 7 boph 6 hr. P/ 100 bopd
Comp 25 bopd
Tops: M. 2258
T.D. 2268'

COMPLETED

County Dickinson Elev. _____
 Sec. 20 Twp. 16 Rge. 4E
 Company Augusta Oil
 Farm Name Kandt No. 2

| TOPS | DEPTH | LOG | DATUM |
|--------|-------|-----|-------|
| Anh. | | | |
| TP. | | | |
| H. | | | |
| Tr. | | | |
| Dg. | | | |
| Bl. | | | |
| L. | | | |
| K.C. | | | |
| B.K.C. | | | |
| Ce. | | | |
| C. | | | |
| M. | | | |
| M. | | | |
| K. | | | |
| Mz. | | | |
| Mq. | | | |
| V. | | | |
| S. | | | |
| S. | | | |
| A. | | | |
| R. | | | |
| PE. | | | |
| G. | | | |
| T.B. | | | |

Loc. in Sec. C N⁷/₂ SW SE

Geol. _____

Contr. _____

Co. tools

Pool _____

NW Lost Springs

FIRST REPORT
 AUG 10 '55

Date Comm. 8-7-55
8" @ 86/70 drlg. 389

Co.

Lse.

No.

Sec.

T.

R.

No County

County Dickinson Elev. 1377
 Sec. 20 Twp. 16 Rge. 1E
 Company Augusta Oil
 FarmName Kandt No. 2

Co.

| TOPS | DEPTH | LOG | DATUM |
|--------|-------------|-----|------------|
| Anb. | | | |
| Tr. | | | |
| H. | | | |
| Dg. | | | |
| Bl. | | | |
| L. | | | |
| K.C. | | | |
| B.K.C. | | | |
| Ce. | | | |
| C. | | | |
| M. | <u>2258</u> | | <u>881</u> |
| M. | | | |
| K. | | | |
| Mz. | | | |
| Mq. | | | |
| V. | | | |
| S. | | | |
| S. | | | |
| A. | | | |
| R. | | | |
| Pe. | | | |
| G. | | | |
| T.D. | <u>2268</u> | | |

Loc. in Sec. C N $\frac{1}{2}$ SWSE
850' SL
1550' EL
 Geol. _____
 Contr. _____
Co. tools
 Pool _____
NW Lost Springs

Use.

| | | | |
|-----------------|--|---|--|
| | | | |
| | | | |
| COMPLETE | | | |
| | | | |
| | | 0 | |

No.

Sec.

T.

R.

Date Comm. 8-7-55 SEP 14 1955
8" @ 86/70 4 $\frac{1}{2}$ " @ 2267 D^D 2271
S/ 7 boph 6 hr. P/ 100 bopd
Comp. 25 bopd