


Section 20 Township 16 Range 4E
Well No. #1 Schmidt
Company Augusta Oil Co.

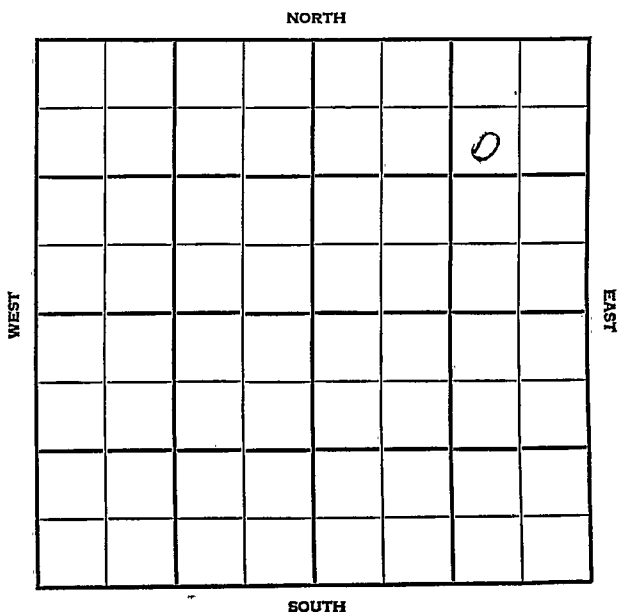

*No County Map*County Dickinson

Elev. _____

Sec. 20Twp. 16Rge. 4ECompany Augusta Oil Co.Farm Name SchmidtNo. 1

TOPS

DEPTH

LOG

DATUM

Loc. in Sec. _____

Anh. _____

SW NE NE

Tp. _____

H. _____

Tr. _____

Dg. _____

BL. _____

L. _____

K.C. _____

B.K.C. _____

Ce. _____

C. _____

M. _____

M. _____

K. _____

Mz. _____

Mq. _____

V. _____

S. _____

S. _____

A. _____

R. _____

Pc. _____

G. _____

TD. _____

2260

2310

Geol. _____

Contr. _____

Co. Tools _____

Pool _____

Wildcat

			10

Date Comm. 10-2-56

FIRST REPORT

8" @ 1851. D & A OCT 10 '56

COMPLETED

5221 15 100

D. M.