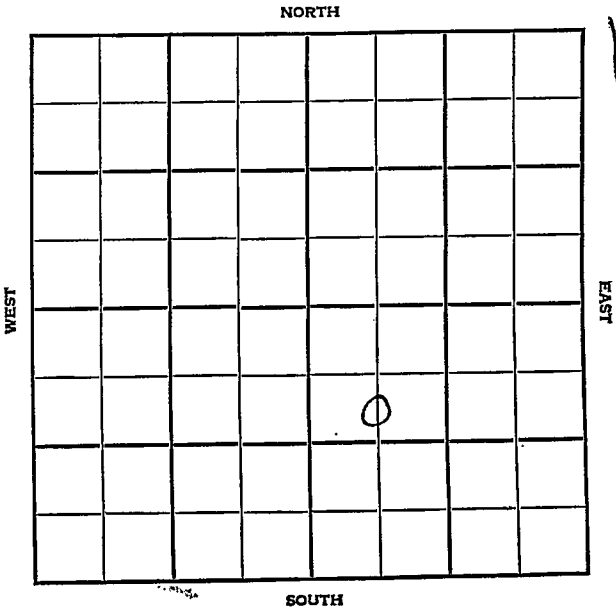


Section 20 Township 16 Range 1E
Well No. #1 Kandt
Company Augusta Oil et al



Dickinson

KANSAS

SEC.	TWP.	R.
20	16	4E

WELL NO.

#1 Kandt

FARM

COMPANY

Augusta Oil et al

CONTRACTOR

Co. Tools.

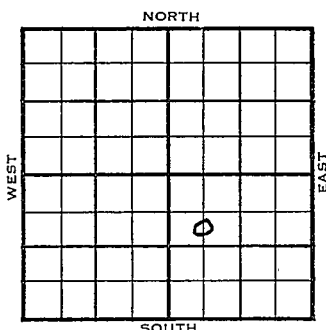
Wildcat.

990 Ft. from N. Line

Ft. from S. Line

Ft. from E. Line

660 Ft. from W. Line

C S $\frac{1}{2}$ NW SE

1955	ELEVATION	REPORT
	1376'	

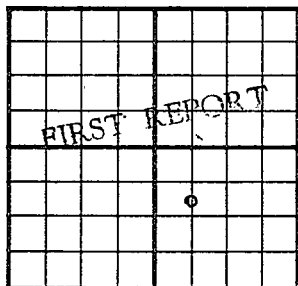
4/6
5/25

R U R

Miss 2267; TD 2295; 8 5/8" 82;
fill 200' oil, est 20' wtr.30 min; fill 1300' oil 250' wtr 1 1/4 hrs
frac; pmp 25 bopd; swb 40 bo plus 10
bw 1st day; pmp 58 bopd 40% wtr;
pmp 25 bopd 40% wtr from Miss 2278-90

COMPLETED

$$\begin{array}{r} 2267 \\ 1376 \\ \hline - 891 \end{array}$$

County Dickinson State KansasSec. 20 (^{Blk.}
Twp.) 16 (^{Sur.}
Rge.) 4E Map No.Operator Augusta Oil etal.Well No. 1 Farm KandtElev. Location C S $\frac{1}{2}$ NW SE990 Ft. From N Line SE660 Ft. From W Line Quarter1st. Report APR 6 1955

Completion

Remarks

Co. tools

Spudding Date

Drlg. Data WildcatR U R

FABEN GILSTRAP