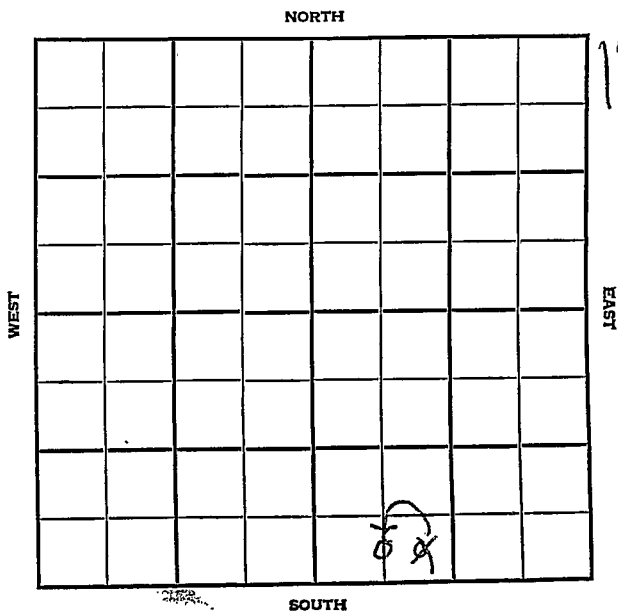


Section 20 Township 16 S Range 14 EWell No. #3 KandtCompany Augusta Oil Co.

DICKINSON

KANSAS

SEC.	TWP.	R.
20	16S	4E

WELL NO.

#3 Kandt

FARM

COMPANY

Augusta Oil Co.

CONTRACTOR

Co. Tools

Lost Springs


Ft. from N. Line

330 Ft. from S. Line

Ft. from E. Line

660 Ft. from W. Line

c s/2
~~SE~~ SW SE

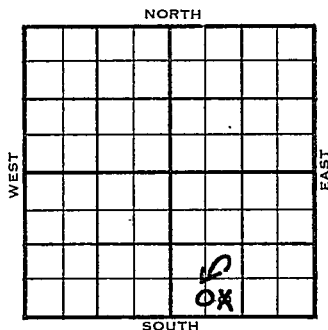

	ELEVATION	REPORT
1955	1373'	

9/21 Comm 9-16-55
 8" @ 85 w/?
 D 325

10/19 Comm. 9-16-55
 8" @ 85 5 1/2" @ 2264 DD 2271'
 7 BFPH 50% wtr. P/3 1/2 BFPH 50% wtr.
 Comp. 25 BOPD. 25 BW
 KC 1670' M. 2254' TD 2265'

COMPLETED

County Dickinson Elev. 4E
 Sec. 20 Twp. 16S Rge. 4E
 Company Augusta Oil Co.
 Farm Name Kandt No. 3

TOPS	DEPTH	LOG	DATUM	Loc. in Sec.
Anh.				SE SW SE
Tp.				
H.				
Tr.				
Dg.				
Bl.				
L.				Geol.
K.C.				Contr.
B.K.C.				Co. tools
Ce.				Pool
C.				Lost Springs
M.				
M.				
K.				
Mz.				
Me.				
V.				
S.				
S.				
A.				
R.				
Pe.				
G.				
T.D.				

Date Comm. 9-16-55

SEP 21 1955

8" 85 w/? ; D 325

SEP 26 1955

Scout Cards	<u>mm^e</u>
Land Small Map	<u> </u>
Land Wall Map	<u> </u>
Tracings	<u> </u>
France Map	<u> </u>
Pierce Map	<u> </u>
Misc.	<u> </u>

DX-201

SEC.

TWP.

R.

20

16

148

WELL NO.

3 Kant.

No Country

FARM

COMPANY

Augusta Oil

CONTRACTOR

CORRECTION

C. $\frac{1}{2}$ SW SE

FT. FROM N. LINE

330

FT. FROM S. LINE

FT. FORM E. LINE

660

FT. FROM W. LINE

NORTH

WEST

EAST

SOUTH

Dickinson County

LOCATION

RIG UP

DRILLING AND REMARKS:

Reported
SE SW SE

RECORD

CASED IN.. FT.

SAND

GAS

OIL

TOTAL DEPTH

1ST 24 HRS. NAT.

1ST 24 HRS. AFTER SHOT

GAS	CU. FT.
1	1
2	2
3	3
100	100

DRY HOLE

ABANDONED

PRODUCTION

DATE _____

SCOUT

OCT 26 1955

L. J. Harris

PK 115-7-100

Scout Cards	<i>mm</i>
Land Small Map	
Land Wall Map	
Tracings	
France Map	
Pierce Map	
Misc.	

NOV 2 1955

20 110

County Dickinson Elev. 1373
 Sec. 20 Twp. 16 Rge. 4E
 Company Augusta Oil
 Farm Name Kandt No. 3

TOPS	DEPTH	LOG	DATUM
Anh.			
Tr.			
H.			
Tr.			
Dg.			
Bl.			
L.			
K.C.	<u>1670</u>		<u>297</u>
B.K.C.			
Ce.			
C.			
M.	<u>2254</u>		<u>881</u>
M.			
K.			
Mz.			
Mq.			
V.			
S.			
S.			
A.			
R.			
Pc.			
G.			
T.D.	<u>2265</u>		

Loc. in Sec.

C S $\frac{1}{2}$ SW SE

Geol.

Contr.

Co. tools

Pool

Lost Springs

COMPLETE

Date Comm. 9-16-55 OCT 19 19558" @ 85 5 $\frac{1}{2}$ " @ 2264 DD2717 bfph 50% wtr. P/ 3 $\frac{1}{2}$ bfph 50% wtr.Domp. 25 bopd 25 bw

First reported as SE SW SE
Completed as C S/2 SW SE.

Please advise.

Mickey
Scouting Dept.

Scout Cards	<i>mm</i>
Land Small Map	
Land Wall Map	
Tracings	
France Map	
Pierce Map	
Misc.	

NOV 2 1955