


DX 78-1 Dickinson

KANSAS

Section 16 20-KGS/DRL Township 16 Range 4E

Well No. #5 Kandt

Company Augusta Oil

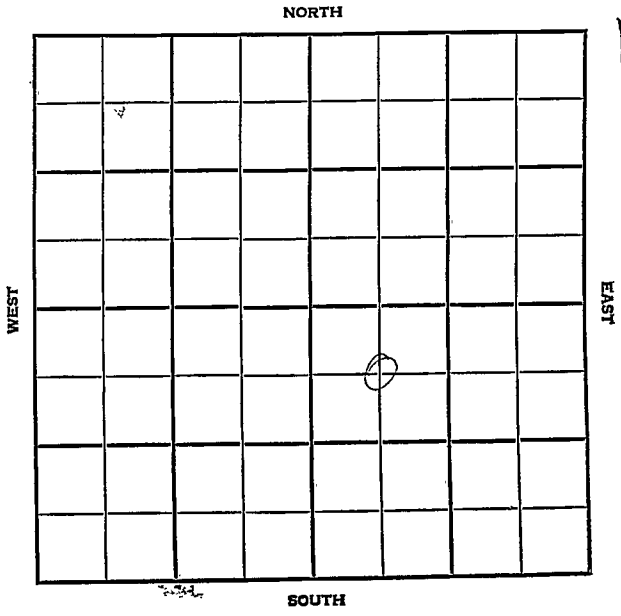

SEC. 15 20	TWP. 16	R. 1E
--------------------------	------------	----------

WELL NO.

#5 Kandt

FARM

COMPANY

Augusta Oil

CONTRACTOR

Co. Tools

NW Lost Springs

FT. FROM N. LINE

2000


FT. FROM S. LINE

2000'

FT. FROM E. LINE

FT. FROM W. LINE

C NW SE

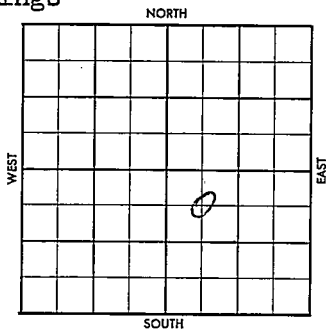

1956	ELEVATION	REPORT
------	-----------	--------

6-6

Comm. 6-4-56

7-3

Comm. 6-4-56

8 5/8" @ 90 w/

5 1/2" @ 2300

DD2332

Tst 2 BO / Lots wtr.

D & A

M.Chat. 2293'

TD 2300'

ABANDONED

No. County Map

County Dickinson Elev. _____
 Sec. 16 Twp. 16 Rgs. 4 E
 Company Augusta Oil
 Farm Name Kandt No. 5

TOPS	DEPTH	LOG	DATUM
Anh.			
Tp.			
H.			
Tr.			
Dg.			
Bl.			
L.			
K.C.			
B.K.C.			
Ce.			
C.			
M.			
M.			
K.			
Mz.			
Ma.			
V.			
S.			
S.			
A.			
R.			
PE.			
G.			
T.D.			

Loc. in Sec. _____
C NW SE
2000' SL
2 000' EL
 Geol. _____
 Contr. _____
Co. tools
 Pool _____
NW Lost Springs

FIRST REPORT
 JUN 6 '56

Date Comm. 6-4-56

JUN 1 1956

R.G.

Co.
Lse.
No.
Sec.
T.
R.

~~10~~
 No. 10

County Dickinson Elev. _____
 Sec. 20 Twp. 16 Rge. 4E
 Company Augusta Oil
 Farm Name Kandt No. 5

TOPS	DEPTH	LOG	DATUM	Loc. in Sec.									
Anh.				C NW SE									
Tp.				2000' SL									
H.				2 000' EL									
Tr.													
Dg.													
Bl.													
L.				Geol. _____									
K.C.				Contr. _____									
BXC.				Co. tools _____									
Ce.				Pool _____									
C.				NW Last Springs									
M. <u>Chat</u>	<u>2293</u>			<table border="1" style="width: 100%; text-align: center;"> <tr> <td colspan="3">ABANDONED</td> </tr> <tr> <td></td> <td>0</td> <td></td> </tr> <tr> <td>JUL</td> <td>3</td> <td>1956</td> </tr> </table>	ABANDONED				0		JUL	3	1956
ABANDONED													
	0												
JUL	3	1956											
M.													
K.													
Mz.													
Mo.													
V.													
S.													
A.													
R.													
PE.													
G.													
TD.	<u>2300</u>												

Date Comm. 6-1-56 JUN 13 '56 JUN 20 '56
8 7/8 90" 5 1/2 @ 2300 JUN 27 '56
JUL 3 '55 DD 2332 TP 75ft 2 BOT
Lots wt.

D & A

Co. No. Sec. T. R.