

Revised
5-16-21E

TYPE

AFFIDAVIT OF COMPLETION FORM

ACO-1 WELL HISTORY

SIDE ONE

Compt. _____

Two (2) copies of this form shall be filed with the Kansas Corporation Commission, 200 Colorado Derby Building, Wichita, Kansas 67202, within thirty (30) days after the completion of a well, regardless of how the well was completed.

F Attach separate letter of request if the information is to be held confidential. If confidential, only file one copy. Information on Side One will be of public record and Side Two will then be held confidential.

Applications must be made on dual completion, commingling, salt water disposal, injection and temporarily abandoned wells.

C Attach one copy only wireline logs (i.e. electrical log, sonic log, gamma ray neutron log, etc.). (Rules 82-2-105 & 82-2-125) KCC# (316) 263-3238. No Log

LICENSE # 5186 RW-KCC EXPIRATION DATE _____

OPERATOR Sterling Oil & Exploration, Inc. API NO. 15-059-22,481

ADDRESS 8080 Ward Parkway, Suite 440 COUNTY Franklin

Kansas City, Missouri 64114 FIELD _____

** CONTACT PERSON W. Terrence Brown PROD. FORMATION Squirrel RW-KCC
PHONE (816)-444-2353

PURCHASER N/A LEASE Lidikay

ADDRESS _____ WELL NO. 3-82

WELL LOCATION _____

DRILLING C & R Drilling, Inc. 1012 1125 Ft. from S Line and

CONTRACTOR 8080 Ward Parkway, Suite 440 2433 2475 Ft. from E Line of (E)

ADDRESS Kansas City, Missouri 64114 KCC the SE (Qtr.) SEC 5 TWP 16 RGE 21 XX

PLUGGING Same

CONTRACTOR _____

ADDRESS _____

TOTAL DEPTH 697 PBTD _____

SPUD DATE 2-15-82 DATE COMPLETED 2-18-82 RW-KCC

ELEV: GR _____ DF _____ KB _____

DRILLED WITH (CABLE) (ROTARY) (AIR) TOOLS.

DOCKET NO. OF DISPOSAL OR REPRESSURING WELL BEING USED TO DISPOSE OF WATER FROM THIS LEASE _____


Amount of surface pipe set and cemented 58' RW-KCC DV Tool Used? _____

THIS AFFIDAVIT APPLIES TO: (Circle ONE) - Oil, Gas, Shut-in Gas, Dry, Disposal, Injection, Temporarily Abandoned, OWWO. Other _____

ALL REQUIREMENTS OF THE STATUTES, RULES AND REGULATIONS PROMULGATED TO REGULATE THE OIL AND GAS INDUSTRY HAVE BEEN FULLY COMPLIED WITH.

WELL PLAT

(Office Use Only)

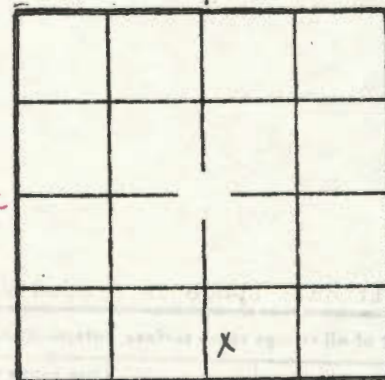

KCC _____
KGS ☒
SWD/REP _____
PLG. _____

AFFIDAVIT

W. Terrence Brown, being of lawful age, hereby certifies that:

I am the Affiant, and I am familiar with the contents of the foregoing Affidavit. The statements and allegations contained therein are true and correct.

WELL RECORD

Well No. 3-82 Farm Lidikay Producer Sterling Oil & Exploration, Inc.
 Location Sec. 5 Twp. 16 Rg. 21-E
 Elevation State Kansas County Franklin
 Kind (Oil, Gas, Water, Dry Hole) Oil Contractor C & R Drilling, Inc.
 Producing formation Squirrel Top Bottom
 Shot with qts. from to
 Packer Set at Kind Size
 Liner from to Perforated from to

LOG

Thick- ness	Strata	Depth	Thick- ness	Strata	Depth
20	Soil & Clay	20	13	Shale	625
5	Lime	25	4	Lime	629
1	Shale	26	7	Shale	636
	Lime	45	12	Lime	648
7	Shale	52	12	Shale	660
10	Lime	62	1	Lime	661
4	Shale	66	3	Shale	664
18	Lime	84	4	Lime	668
40	Shale	124			
18	Lime	142			
78	Shale	220		19" Core	
22	Lime	242			
27	Shale	269		TD 697	
7	Lime	276			
22	Shale	298			
3	Lime	301			
	Shale	335			
22	Lime	357			
8	Shale	365			
23	Lime	388			
	Shale	393			
5	Lime	398			
3	Shale	401			
11	Lime	412			
65	Shale	577			
6	Lime	583			
7	Shale	590			
9	Lime	599			
5	Shale	604			
8	Lime	612			

Total Depth

Open Hole

Casing at

Casing at

Casing at

Cement

Tubing

Rods

Additional Information

State Geological Survey
 WICHITA BRANCH

RECEIVED
 STATE CORPORATION COMMISSION

JUL 25 1983

CONSERVATION DIVISION
 Wichita, Kansas

Date Completed

O. K.

Superintendent