

TYPE AFFIDAVIT OF COMPLETION FORM **ACO-1 WELL HISTORY**
SIDE ONE Compt. _____

Two (2) copies of this form shall be filed with the Kansas Corporation Commission, 200 Colorado Derby Building, Wichita, Kansas 67202, within thirty (30) days after the completion of a well, regardless of how the well was completed.

F Attach separate letter of request if the information is to be held confidential. If confidential, only file one copy. Information on Side One will be of public record and Side Two will then be held confidential.

Applications must be made on dual completion, commingling, salt water disposal, injection and temporarily abandoned wells.

C Attach one copy only wireline logs (i.e. electrical log, sonic log, gamma ray neutron log, etc.). (Rules 82-2-105 & 82-2-125) KCC# (316) 263-3238. No Log

LICENSE # 5186 RAW-KC **EXPIRATION DATE** _____

OPERATOR Sterling Oil & Exploration, Inc. **API NO.** 15-059-22,482

ADDRESS 8080 Ward Parkway, Suite 440 **COUNTY** Franklin

Kansas City, Missouri 64114 **FIELD** _____

**** CONTACT PERSON** W. Terrence Brown **PROD. FORMATION** Squirrel RAW-KCC
PHONE (816)-444-2353

PURCHASER N/A **LEASE** Lidikay

ADDRESS _____ **WELL NO.** 4-82

WELL LOCATION NW SW SE

DRILLING CONTRACTOR C & R Drilling, Inc. 685 800 Ft. from s Line and

ADDRESS 8080 Ward Parkway, Suite 440 2450 2475 Ft. from E Line of (E)

Kansas City, Missouri 64114 116 the SE 1/4 (Qtr.) SEC 5 TWP 16 RGE 21 N 1/2

PLUGGING CONTRACTOR Same

ADDRESS _____


TOTAL DEPTH 687 **PBTD** _____

SPUD DATE 2-17-82 **DATE COMPLETED** 2-21-82 RAW-KC

ELEV: GR _____ **DF** _____ **KB** _____

DRILLED WITH (CABLE) (ROTARY) **(AIR) TOOLS.**

DOCKET NO. OF DISPOSAL OR REPRESSURING WELL BEING USED TO DISPOSE OF WATER FROM THIS LEASE _____

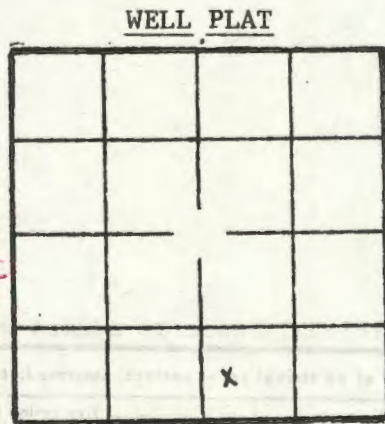

(Office Use Only)
KCC _____
KGS
SWD/REP _____
PLG. _____

Amount of surface pipe set and cemented 52' RAW-KC DV Tool Used? _____

THIS AFFIDAVIT APPLIES TO: (Circle ONE) - Oil, Gas, Shut-in Gas, Dry, Disposal, Injection, Temporarily Abandoned, OWWO. Other _____

ALL REQUIREMENTS OF THE STATUTES, RULES AND REGULATIONS PROMULGATED TO REGULATE THE OIL AND GAS INDUSTRY HAVE BEEN FULLY COMPLIED WITH.

A F F I D A V I T

W. Terrence Brown, being of lawful age, hereby certifies that:

I am the Affiant, and I am familiar with the contents of the foregoing Affidavit. The statements and allegations contained therein are true and correct.

WELL RECORD

P1

Well No. 4 Farm Lidikay Producer Sterling Oil & Exploration, Inc.

Location Sec. 5 Twp. 16 Rg. 21-E

Elevation State Kansas County Franklin

Kind (Oil, Gas, Water, Dry Hole) Oil Contractor C & R Drilling, Inc.

Producing formation Squirrel Top Bottom

Shot with qts. from to

Packer Set at Kind Size

Liner from to Perforated from to

LOG

Thickness	Strata	Depth	Thickness	Strata	Depth
19	Soil & Clay	19	6	Shale	599
4	Lime	23	3	Lime	602
3	Shale	26	17	Shale	619
16	Lime	42	4	Lime	623
7	Shale	49	7	Black Shale Slate	630
12	Lime	61	15	Lime	645
3	Shale	64	11	Shale	656
18	Lime	82	1	Lime	657
40	Shale	122	2	Shale	659
17	Lime	139	4	Lime	663
78	Shale	217	4	Shale	667
22	Lime	239			
28	Shale	267			
7	Lime	274		TD 687	
21	Shale	295			
	Lime	300			
31	Shale	331			
25	Lime	356			
8	Shale	364			
	Lime	386			
4	Shale	390			
5	Lime	395			
3	Shale	398			
4	Lime	402			
160	Shale	562			
3	Lime	565			
7	Shale	572			
7	Lime	579			
6	Shale	585			
8	Lime	593			

Total Depth

Open Hole

Casing at

Casing at

Casing at

Cement

Tubing

Rods

Additional Information

State Geological Survey
WICHITA BRANCH

RECEIVED
STATE CORPORATION COMMISSION
JUL 25 1983
CONSERVATION DIVISION
Wichita, Kansas

Date Completed _____ O. K. _____ Superintendent _____