

KANSAS DRILLERS LOG

API No. 15 — 059 — 20,269
County Number

Operator
Rader Oil Co.

Address
Route #1 Eudora, Kansas 66025

Well No. #3 Lease Name McGlashon

Well Location
744 feet from (N) (S) line 1200 feet from (E) (W) line

Principal Contractor Kent Drilling Co. Geologist Dick Rader


Spud Date August 16, 1976 Total Depth 724 P.B.T.D.

Date Completed August 20, 1976 Oil Purchaser

S. 7 T. 16 R. 21 E W

Loc. NE SW SW

County Franklin

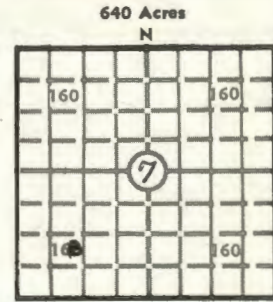

Elev.: Gr. _____

DF _____ KB _____

CASING RECORD

Report of all strings set— surface, intermediate, production, etc.

Purpose of string	Size hole drilled	Size casing set (in O.D.)	Weight lbs/ft.	Setting depth	Type cement	Sacks	Type and percent additives
Surface	8 5/8	7	24	40	common	5	

LINER RECORD

PERFORATION RECORD

Top, ft.	Bottom, ft.	Sacks cement	Shots per ft.	Size & type	Depth interval

TUBING RECORD

Size	Setting depth	Packer set at

ACID, FRACTURE, SHOT, CEMENT SQUEEZE RECORD

Amount and kind of material used	Depth interval treated

INITIAL PRODUCTION

Date of first production	Producing method (flowing, pumping, gas lift, etc.)				
RATE OF PRODUCTION PER 24 HOURS	Oil	Gas	Water	Gas-oil ratio	
	bbls.	MCF	bbls.	CFPB	
Disposition of gas (vented, used on lease or sold)			Producing interval (s)		

INSTRUCTIONS: As provided in KCC Rule 82-2-125, within 90 days after completion of a well, one completed copy of this Drillers Log shall be transmitted to the State Geological Survey of Kansas, 4150 Monroe Street, Wichita, Kansas 67209. Copies of this form are available from the Conservation Division, State Corporation Commission, 3830 So. Meridian (P.O. Box 17027), Wichita, Kansas 66217. Phone AC 316-522-2206. If confidential custody is desired, please note Rule 82-2-125. Drillers Logs will be on an open file in the Oil and Gas Division, State Geological Survey of Kansas, Lawrence, Kansas 66044.

Operator Rader Oil Co. DESIGNATE TYPE OF COMP.: OIL, GAS, DRY HOLE, SWDW, ETC.:

Well No. 3 Lease Name McGlashon Dry Hole

S 7 T 16 R 21 E

WELL LOG

Show all important zones of porosity and contents thereof; cored intervals, and all drill-stem tests, including depth interval tested, cushion used, time tool open, flowing and shut-in pressures, and recoveries.

SHOW GEOLOGICAL MARKERS, LOGS RUN, OR OTHER DESCRIPTIVE INFORMATION.

FORMATION DESCRIPTION, CONTENTS, ETC.	TOP	BOTTOM	NAME	DEPTH
Soil & Clay	0	8		
Lime	8	30		
Blk. Shale	30	38		
Lime	38	68		
Shale	68	110		
Lime	110	130		
Shale	130	206		
Lime	206	228		
Shale	228	235		
Lime Shells	235	284		
Lime	284	292		
Shale	284 292	324		
Lime	324	340		
Shale	340	351		
Lime	351	373		
Shale	373	378		
Lime	378	382		
Shale	382	387		
Lime	387	390		
Shale	390	565		
Lime	565	574		
Shale	574	583		
Lime	583	585		
Shale	585	593		
Lime	593	596		
Shale	596	610		
Lime	610	614		
Shale	614	623		
Lime	623	627		
Shale & Shells	627	659		
Dry Sand	659	667	1 st. Squirrel	659-667
Shale	667	700		
Lime	700	702		
Shale & Shells	702	724 TD		

USE ADDITIONAL SHEETS, IF NECESSARY, TO COMPLETE WELL RECORD.

Date Received	<i>Richard Rader</i>
	Signature
	Owner
	Title
	August 23, 1976
	Date