

KANSAS DRILLERS LOG

State Geological Survey
WICHITA, BRANCH


API No. 15 — 121 — 20,231
County Number

S. 24 T. 16 R. 21 E

Loc. 20 FEL 1100 FNL SE

County Miami SE NE SE

640 Acres
N

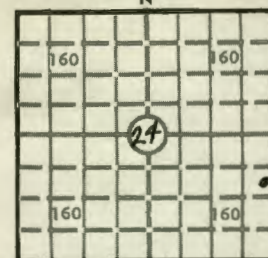

Locate well correctly

Elev.: Gr. _____

DF _____ KB _____

Operator Reese Enterprises, Inc.	
Address Box 11598 Kansas City, Missouri	
Well No. #5	Lease Name Cayot
Footage Location 1100' feet from (N) line 220' feet from (E) line SE 1/4	
Principal Contractor Kent Drilling Co.	Geologist
Spud Date July 24, 1974	Total Depth 720'
Date Completed July 28, 1974	P.B.T.D. 711.9
Oil Purchaser Bluebird Oil Co.s	

CASING RECORD

Report of oil strings set — surface, intermediate, production, etc.

Purpose of string	Size hole drilled	Size casing set (in O.D.)	Weight lbs/ft.	Setting depth	Type cement	Sacks	Type and percent additives
Production	6 1/4	4 1/2	9.5	720'	Bulk	105	2 sacks Jell 4 sacks Salt

LINER RECORD

PERFORATION RECORD

Top, ft.	Bottom, ft.	Sacks cement	Shots per ft.	Size & type	Depth interval
0			1	Glass	682.6 to 690

Size	Setting depth	Packer set at
2"	682'	None

ACID, FRACTURE, SHOT, CEMENT SQUEEZE RECORD

Amount and kind of material used	Depth interval treated
50 gal. 15% Acid, 30 sx. sand with 105 bbl. oil	682.6 to 690

INITIAL PRODUCTION

Date of first production August 26, 1974		Producing method (flowing, pumping, gas lift, etc.) Pumping	
RATE OF PRODUCTION PER 24 HOURS	Oil 10 bbls.	Gas 0 MCF	Water 0 bbls.
Disposition of gas (vented, used on lease or sold) Vented		Producing interval (s) 682.6 to 690	

INSTRUCTIONS: As provided in KCC Rule 82-2-125, within 90 days after completion of a well, one completed copy of this Drillers Log shall be transmitted to the State Geological Survey of Kansas, 4150 Monroe Street, Wichita, Kansas 67209. Copies of this form are available from the Conservation Division, State Corporation Commission, 3830 So. Meridian (P.O. Box 17027), Wichita, Kansas 66217. Phone AC 316-522-2206. If confidential custody is desired, please note Rule 82-2-125. Drillers Logs will be on open file in the Oil and Gas Division, State Geological Survey of Kansas, Lawrence, Kansas 66044.

Operator
Reese Enterprises Inc.

DESIGNATE TYPE OF COMP.: OIL, GAS,
DRY HOLE, SWDW, ETC.:
Oil

Well No. 5 Lease Name Cayot

S 24 T 16 R 21 X


WELL LOG

Show all important zones of porosity and contents thereof; cored intervals, and all drill-stem tests, including depth interval tested, cushion used, time tool open, flowing and shut-in pressures, and recoveries.

SHOW GEOLOGICAL MARKERS, LOGS RUN,
OR OTHER DESCRIPTIVE INFORMATION.

FORMATION DESCRIPTION, CONTENTS, ETC.	TOP	BOTTOM	NAME	DEPTH
Soil & Clay	14	63 14	Squirrel	T.D. 720
Lime	18	32		
Shale	4	36		
Lime	13	49		
Shale	10	59		
Lime	16	75		
Shale	26	101		
Lime	15	116		
Shale	95	211		
Lime	20	231		
Shale	30	261		
Lime	6	266		
Shale	23	290		
Lime	19	309		
Shale	17	326		
Lime	24	350		
Shale	8	358		
Lime	29	387		
Shale	4	391		
Lime	6	397		
Shale	169	566		
Lime	8	574		
Shale	9	583		
Lime	2	585		
Shale	17	602		
Lime	6	608		
Shale	16	624		
Lime	4	628		
Shale	6	634		
Lime	5	639		
Shale & Shells	16	655		
Lime	5	660		
Shale	19	679		
Broken Oil Sand	2	681		
Oil Sand	9	690		
Sandy Shale	5	695		
Shale	25	720 T.D.		

USE ADDITIONAL SHEETS, IF NECESSARY, TO COMPLETE WELL RECORD.

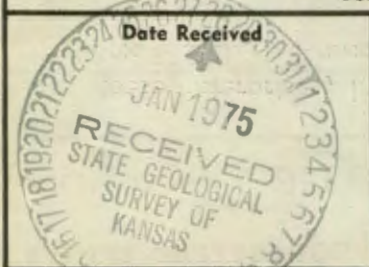

Signature: Jack W. Sanders
Title: Superintendent
Date: 11-17-74