

KANSAS DRILLERS LOG

State Geological Survey
WICHITA, BRANCH

API No. 15 — 121 — 20,232
County Number

S. 24 T. 16 R. 21 E
Loc. 20 FEL 1100 FNL SE
County Miami NE SE SE
640 Acres
N
KCC

Operator
Reese Enterprises, Inc.

Address Box 11598 Kansas City, Missouri


Well No. #6 Lease Name Cayot

Footage Location 1120 FSL: 220 FEL - KCC
1100' feet from (N) (S) line 220 feet from (E) (W) line 851

Principal Contractor Kent Drilling Co. Geologist

Spud Date July 28, 1974 Total Depth 720' P.B.T.D. 690'

Date Completed August 1, 1974 Oil Purchaser Bluebird Oil Co.

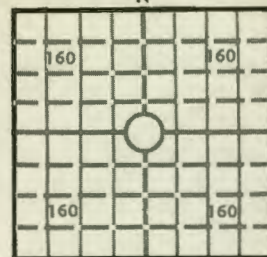

Elev.: Gr. _____
DF. _____ KB _____

CASING RECORD

Report of all strings set — surface, intermediate, production, etc.

Purpose of string	Size hole drilled	Size casing set (in O.D.)	Weight lbs/ft.	Setting depth	Type cement	Sacks	Type and percent additives
Production	6 1/4	4 1/2	9.5	720'	Bulk	105	2 sacks Jell 4 sacks Salt

LINER RECORD

PERFORATION RECORD

Top, ft.	Bottom, ft.	Sacks cement	Shots per ft.	Size & type	Depth interval
0			1	Glass	675 to 687

Size	Setting depth	Packer set at
2"	675'	None

ACID, FRACTURE, SHOT, CEMENT SQUEEZE RECORD

Amount and kind of material used	Depth interval treated
50 gal. 15% Acid, 30 sx. sand with 105 bbl. oil	675 to 687

INITIAL PRODUCTION

Date of first production August 26, 1974 Producing method (flowing, pumping, gas lift, etc.) Pumping

RATE OF PRODUCTION PER 24 HOURS
Oil 10 bbls. Gas 0 MCF Water 0 bbls. Gas-oil ratio CFPB

Disposition of gas (vented, used on lease or sold) Vented Producing interval (s) 675 to 687

INSTRUCTIONS: As provided in KCC Rule 82-2-125, within 90 days after completion of a well, one completed copy of this Drillers Log shall be transmitted to the State Geological Survey of Kansas, 4150 Monroe Street, Wichita, Kansas 67209. Copies of this form are available from the Conservation Division, State Corporation Commission, 3830 So. Meridian (P.O. Box 17027), Wichita, Kansas 66217. Phone AC 316-522-2206. If confidential custody is desired, please note Rule 82-2-125. Drillers Logs will be on open file in the Oil and Gas Division, State Geological Survey of Kansas, Lawrence, Kansas 66044.

Operator

Reese Enterprises Inc.

DESIGNATE TYPE OF COMP.: OIL, GAS,
DRY HOLE, SWDW, ETC.:

Oil

Well No.

6

Lease Name

Cayot

S 24 T 16 R 21 E

WELL LOG


Show all important zones of porosity and contents thereof; cored intervals, and all drill-stem tests, including depth interval tested, cushion used, time tool open, flowing and shut-in pressures, and recoveries.

SHOW GEOLOGICAL MARKERS, LOGS RUN,
OR OTHER DESCRIPTIVE INFORMATION.

FORMATION DESCRIPTION, CONTENTS, ETC.	TOP	BOTTOM	NAME	DEPTH
Soil & Clay	14	14	Soil & Clay	700'
Lime	19	34		
Shale	34	37		
Lime	37	48		
Shale	48	59		
Lime	59	78		
Shale	78	99		
Lime	99	114		
Shale	114	206		
Lime	206	227		
Shale	227	258		
Lime	258	263		
Shale	263	285		
Lime	285	304		
Shale	304	322		
Lime	322	349		
Shale	349	357		
Lime	357	386		
Shale	386	389		
Lime	389	396		
Shale	396	562		
Lime	562	570		
Shale & Shells	570	600		
Lime	600	605		
Shale	605	622		
Lime	622	626		
Shale	626	637		
Lime	637	641		
Shale	641	649		
Lime	649	653		
Shale & Shells	653	672		
Sandy Shale	672	675		
Oil Sand	675	691		
Sandy Shale	691	693		
Shale	693	720T.D.		

USE ADDITIONAL SHEETS, IF NECESSARY, TO COMPLETE WELL RECORD.

Date Received

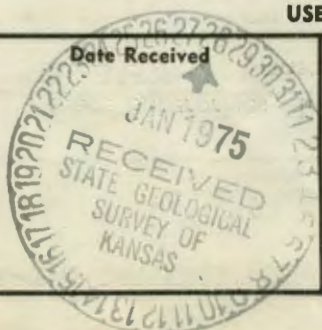

Signature

Title

Date

11-17-74