

KANSAS DRILLERS LOG

State Geological Survey
WICHITA, BRANCHAPI No. 15 — 121 — 20,233
County Number

Operator

Reese Enterprises, Inc.

Address Box 11598 Kansas City, Missouri 64138

Well No.

#7

Lease Name

Cayot

Footage Location

1100 feet from (N) (S) line SE 1/4 1560 FSL: 660 FGL-1CCC
660 feet from (E) (W) line

Principal Contractor

Kent Drilling Co.

Geologist

Spud Date

August 20, 1974

Total Depth

750'

P.B.T.D.

714.1'

Date Completed

August 25, 1974

Oil Purchaser

Bluebird Oil Co.


S. 24 T. 16 R. 21 E W

Loc. 660 FEL 1100 FNL SE

County Miami

640 Acres
N

1CCC

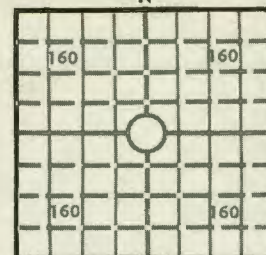

Locate well correctly

Elev.: Gr.

DF

KB

CASING RECORD

Report of all strings set — surface, intermediate, production, etc.

Purpose of string	Size hole drilled	Size casing set (in O.D.)	Weight lbs/ft.	Setting depth	Type cement	Sacks	Type and percent additives
Production	6 1/2	4 1/2	9.5	750'	Bulk	105	2 sacks Jell 4 sacks Salt

LINER RECORD

PERFORATION RECORD

Top, ft.	Bottom, ft.	Sacks cement	Shots per ft.	Size & type	Depth interval
0			1	Glass	674.5 to 678.5

TUBING RECORD

Size	Setting depth	Packer set at
2"	674'	None

ACID, FRACTURE, SHOT, CEMENT SQUEEZE RECORD

Amount and kind of material used	Depth interval treated
50 gal. 15% Acid, 30sx. sand with 105 bbl. oil	674.5 to 678.5

INITIAL PRODUCTION

Date of first production		Producing method (flowing, pumping, gas lift, etc.)					
Sept. 3, 1974		Pumping					
RATE OF PRODUCTION PER 24 HOURS	Oil	10	Gas	0	Water	0	Gas-oil ratio
		bbls.		MCF		bbls.	CFPB
Disposition of gas (vented, used on lease or sold)					Producing interval(s)		
Vented					674.5 to 678.5		

INSTRUCTIONS: As provided in KCC Rule 82-2-125, within 90 days after completion of a well, one completed copy of this Drillers Log shall be transmitted to the State Geological Survey of Kansas, 4150 Monroe Street, Wichita, Kansas 67209. Copies of this form are available from the Conservation Division, State Corporation Commission, 3830 So. Meridian (P.O. Box 17027), Wichita, Kansas 66217. Phone AC 316-522-2206. If confidential custody is desired, please note Rule 82-2-125. Drillers Logs will be on open file in the Oil and Gas Division, State Geological Survey of Kansas, Lawrence, Kansas 66044.

Operator
Reese Enterprises Inc.

DESIGNATE TYPE OF COMP.: OIL, GAS,
DRY HOLE, SWDW, ETC.:

Oil

Well No.

7

Lease Name

Cayot

S 24 T 16 R 21 E

WELL LOG


Show all important zones of porosity and contents thereof; cored intervals, and all drill-stem tests, including depth interval tested, cushion used, time tool open, flowing and shut-in pressures, and recoveries.

SHOW GEOLOGICAL MARKERS, LOGS RUN,
OR OTHER DESCRIPTIVE INFORMATION.

FORMATION DESCRIPTION, CONTENTS, ETC.	TOP	BOTTOM	NAME	DEPTH
Soil & Clay	7	7	Squirrel	7
Lime	19	26		
Shale	5	31		
Lime	11	42		
Shale	11	53		
Lime	15	68		
Shale	27	95		
Lime	15	110		
Shale	91	210		
Lime	19	220		
Shale	33	253		
Lime	5	258		
Shale	27	285		
Lime	17	302		
Shale	18	320		
Lime	25	345		
Shale	7	352		
Lime	22	374		
Shale	3	377		
Lime	15	392		
Shale	167	559		
Lime	7	566		
Shale	30	596		
Lime	8	604		
Shale	16	620		
Lime	4	624		
Shale & Shells	22	646		
Lime	4	650		
Shale	12	662		
Br. Lime	2	664		
Shale	6	670		
Oil Sand	14	684		
Sandy Shale	6	690		
Shale & Shells	50	740		
Sandy Shale Shal	4	744		
Shale	6	750 T.D.		

USE ADDITIONAL SHEETS, IF NECESSARY, TO COMPLETE WELL RECORD.

Date Received

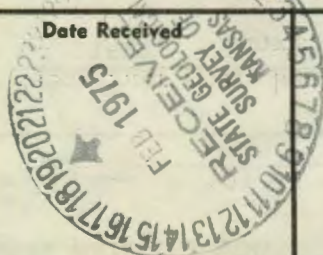

Jack W. Sanders

Signature

Production Supt.

Title

Dec. 30, 1974

Date