

KANSAS

15-121-20,864

WELL COMPLETION REPORT AND DRILLER'S LOG

S. 26 T. 16 R. 21 E
 W
 Loc. 150' FEL & 810' SL W2 SW
 County Miami NW SE SW-KCC

API No. 15 — 121 — 20,864
 County Number

Operator
P & W Oil

Address
5987 Miller St. Arvada, Colorado 80004


Well No. #S-12 Lease Name Sharpe

Footage Location 810 986 FSL & 3413 FEL - KCC 150
 feet from (N) (S) line feet from (E) (W) line

Principal Contractor Wellsville Development Geologist ---

Spud Date March 30, 79 Date Completed April 3, 79 Total Depth 715' P.B.T.D.

Directional Deviation Oil and/or Gas Purchaser Town Oil

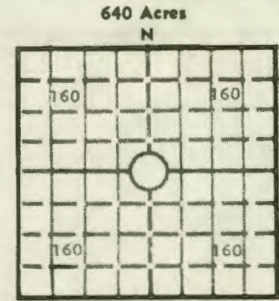

Locate well correctly

Elev.: Gr. _____

DF _____ KB _____

CASING RECORD

Report of all strings set — surface, intermediate, production, etc.

Purpose of string	Size hole drilled	Size casing set (in O.D.)	Weight lbs/ft.	Setting depth	Type cement	Sacks	Type and percent additives
surface	8-1/8"	6-1/4"	17#	25	Neet	1	
production	5-1/4"	2-3/8"	3.75#	651'	Portland A	80	2% gel

LINER RECORD

PERFORATION RECORD

Top, ft.	Bottom, ft.	Sacks cement	Shots per ft.	Size & type	Depth interval

Size	Setting depth	Packer set at
2-3/8"	651'	651'

ACID, FRACTURE, SHOT, CEMENT SQUEEZE RECORD

Amount and kind of material used	Depth interval treated
40 sx 12-30 snad	651'-657'
50 sx 10-20 sand	
75# water gel	

INITIAL PRODUCTION

Date of first production <u>May 16, 1979</u>	Producing method (flowing, pumping, gas lift, etc.) <u>pumping</u>		
RATE OF PRODUCTION PER 24 HOURS	Oil <u>3</u> bbls.	Gas <u>0</u> MCF	Water <u>0</u> bbls.
Disposition of gas (vented, used on lease or sold)	<u>na</u>		Producing interval (s) <u>651-657</u>

INSTRUCTIONS: As provided in KCC Rule 82-2-125, within 90 days after completion of a well, one completed copy of this Drillers Log shall be transmitted to the State Geological Survey of Kansas, 4150 Monroe Street, Wichita, Kansas 67209. Copies of this form are available from the Conservation Division, State Corporation Commission, 245 No. Water, Wichita, Kansas 67202. Phone AC 316-522-2206. If confidential custody is desired, please note Rule 82-2-125. Drillers Logs will be on open file in the Oil and Gas Division, State Geological Survey of Kansas, Lawrence, Kansas 66044.

26-16-21E

Farm - Sharp

Contractor - Wellsville Development, Inc

County -

Drilling Started -

Well - S-12

Drilling Completed -

Lease Owner - P&W

Permanent Casing

<u>Size</u>	<u>Amount</u>	<u>Condition</u>	<u>Cement</u>
<u>Strata</u>	<u>Total Depth</u>	<u>Strata</u>	<u>Total Depth</u>
Soil & Clay	8	Shale	645
Lime	13	Lime	651
Slate	24	Oil Sand	657
Lime	32	Shale	715 T.D.
Shale	36		
Lime	52		
Shale	58		
Lime	71		
Shale & Shells	171		
Lime	185		
Shale & Shells	200		
Lime	205		
Shale	216		
Lime	224		
Shale	246		
Lime	261		
Shale	275		
Lime	287		
Shale	291		
Lime	303		
Shale	312		
Lime	331		
Shale	336		
Lime	341		
Shale & Shells	345		
Lime Shells	355		
Shale	505		
Lime	515		
Shale & Shells	527		
Lime	530		
Shale	555		
Lime	565		
Shale	575		
Lime	580		
Shale	585		
Lime	587		
Shale	596		
Lime	600		
Shale	610		
Lime	614		
Shale	620		
Lime & Shells	630		