

Section 21 Township 16 Range 1E

Well No. #1 Hacker

Company Eldorado Ref.

NORTH

0							

SOUTH

WEST

EAST

13

Sec. 21 Twp. 16 R. 1-E

Well No. #1 Hacker Farm

Eldorado Ref. Company


(Wildcat)

 Ft. from N. Line

330 Ft. from S. Line

 Ft. from E. Line

330 Ft. from W. Line

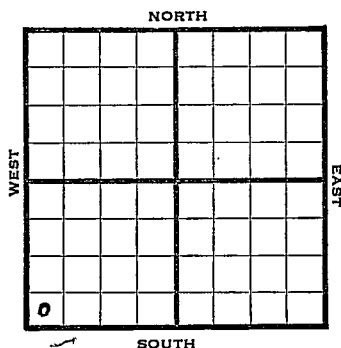

1944

REPORT

5/17

8" - 148

Waiting on cement

5/24

Drlg. 2070

5/31

Drlg. 2450

6/7

Miss. 2734

TD 2775'


ABANDONED

KANSASPool Name WildcatMap No. 25 Sec. 21 Twp. 16 R. 1EWell No. 1 Hacker

Eldorado Ref. _____ Company _____

FIRST REPORT Contractor _____

SW/C

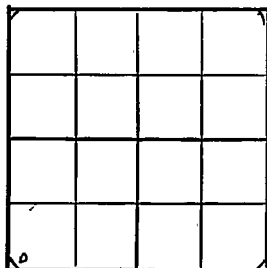SECTION PLAT

_____ Ft. from N. Line

330 Ft. from S. Line

_____ Ft. from E. Line

330 Ft. from W. LineDickinson County

Location _____

Rig up _____

Drilling and Remarks:

8" - 148 WOC**RECORD**

Cased _____ in., _____ ft.

Sand _____

Gas _____

Oil _____

Total Depth _____

PRODUCTION

1st 24 hrs. Nat. _____

1st 24 hrs. after shot _____

Gas _____ Cu. Ft.

Dry Hole _____

Abandoned _____

Date

MAY 17 1944 19S. J. LEWIS Scout

Pool Name Wildcat**KANSAS**Map No. 25 Sec. 21 Twp. 16 R. 1EWell No. 1 HackerEldorado Ref.

Company

ABANDONED

Contractor

SW/C

SECTION PLAT

Ft. from N. Line

330

Ft. from S. Line

Ft. from E. Line

330

Ft. from W. Line

Dickinson County

Location

Rig up

Drilling and Remarks:

Miss 2734

RECORD

Cased _____ in., _____ ft.

Sand _____

Gas _____

Oil _____

Total Depth 2725

PRODUCTION

1st 24 hrs. Nat. _____

1st 24 hrs. after shot _____

Gas _____ Cu. Ft.

Dry Hole _____

Abandoned _____

Date

JUN 7 1944 19S. J. LEWIS

Scout