SIDE ONE

STATE CORPORATION COMMISSION OF KANSAS
OIL & GAS CONSERVATION DIVISION

WELL COMPLETION OR RECOMPLETION FORM
ACO-1 WELL HISTORY

API NO. 15 - 121-26,214

County Miami

NW Sec 31 Twp 16 Rge 22 X E W
(location)

3385 Ft North from Southeast Corner of Secti
3830 Ft West from Southeast Corner of Secti
(Note: locate well in section plat below)

Lease Name Bourquin Well# 14

Field Name Paola

Producing Formation Squirrel

Elevation: Ground Unknown KB

DESCRIPTION OF WELL AND LEASE

Operator: license # 5341
name Glenn A. Evans
address Suite 11 Professional Bldg.
401 S. Main
City/State/Zip Ottawa, KS 66067

Operator Contact Person Glenn A. Evans
Phone 913-242-5733

Contractor: license # 5353
name Bloomer Well Service

Wellsite Geologist none
Phone

PURCHASER Amoco

Designate Type of Completion

[X] New Well [ ] Re-Entry [ ] Workover

[X] Oil [ ] SWD [ ] Temp Abd
[ ] Gas [ ] Inj [ ] Delayed Comp.
[ ] Dry [ ] Other (Core, Water Supply etc.)

If **WWO:** old well info as follows:
Operator
Well Name
Comp. Date Old Total Depth

Section Plat

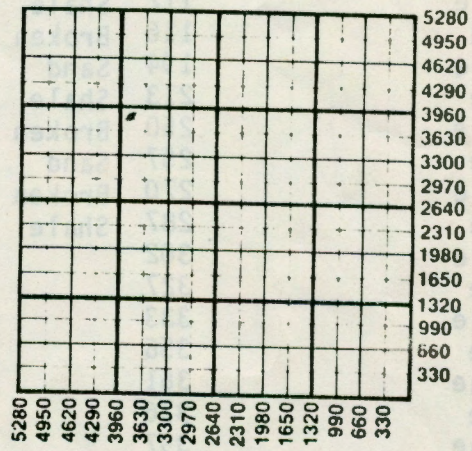

WELL HISTORY

Drilling Method: [X] Mud Rotary [ ] Air Rotary [ ] Cable

6/23/84	6/27/84	8/1/84
Spud Date	Date Reached TD	Completion Date

704	N/A
Total Depth	PBTD

Amount of Surface Pipe Set and Cemented at 23.6 feet

Multiple Stage Cementing Collar Used? [ ] Yes [X] No

If Yes, Show Depth Set feet

If alternate 2 completion, cement circulated
from 23.6 feet depth to surface w/ 8 SX cmt

Wire line log received

WATER SUPPLY INFORMATION

Source of Water: N/A

Division of Water Resources Permit #

[ ] Groundwater Ft North From Southeast Corner an
(Well) Ft. West From Southeast Corner
Sec Twp Rge [ ] East [ ] West

[ ] Surface Water Ft North From Sourtheast Corner an
(Stream, Pond etc.) Ft West From Southeast Corne
Sec Twp Rge [ ] East [ ] West

[ ] Other (explain)
(purchased from city, R.W.D.#)

Disposition of Produced Water: [ ] Disposal [X] Repressuring

Docket # CR 68327
C-22,110

TUBING RECORD size 1" set at 664 packer at | Liner Run [ ] Yes [X] No

Date of First Production	Producing method					
8/1/84	[ ] flowing	[X] pumping	[ ] gas lift	[ ] Other (explain)		

	Oil	Gas	Water	Gas-Oil Ratio	Gravity
Estimated Production Per 24 Hours	3		20%		30

SID: 0

Operator Name Glenn A. Evans Lease Name Bourquin Well# A1 SEC 31 TWP. 16 RGE. 22 ☒ East ☐ West

WELL LOG

INSTRUCTIONS: Show important tops and base of formations penetrated. Detail all cores. Report all drill st... test giving interval tested, time tool open and closed, flowing and shut-in pressures, whether shut-in pressure reached stati level, hydrostatic pressures, bottom hole temperature, fluid recovery, and flow rates if gas to surface during test. Attac extra sheet if more space is needed. Attach copy of log.

Drill Stem Tests Taken ☐ Yes ☒ No
Samples Sent to Geological Survey ☐ Yes ☒ No
Cores Taken ☒ Yes ☐ No

Formation Description ☐ Log ☐ Sample

Name	Top	Bottom
Soil & Clay	8	
Lime	12	
Shale	16	
Lime	33	
Shale	42	
Lime	59	
Shale	81	
Lime	94	
Shale	112	
Sand	116	
Shale	194	
Lime	213	
Shale	250	
Lime	257	
Shale	270	
Lime	287	
Shale	302	
Lime	327	
Shale	333	
Lime	356	
Shlae	361	
Lime	376	
Shlae	397	
Sand	408	
Shlae	484	
Sand	488	
Shale	541	
LIme	549	
Shale	554	
Lime	561	
Shale	581	
Lime	587	
Broken Sand	588	
Sand	591	
Shale	604	
Lime	607	
Shale	623	
LIme	628	
Shale	639	
Lime	643	
Shale	646	
Slate	648	
Shale	659	
Broken Sand	660	
Sand	661	
Shale	663	
Broken Sand	665	
Sand	675	
Broken Sand	677	
Shale	704	

CASING RECORD ☐ new ☐ used

Report all strings set - conductor, surface, intermediate, production, etc.

Purpose of string	size hole drilled	size casing set (in O.D.)	weight lbs/ft.	setting depth	type of cement	# sacks used	type and percent additives
Surface	8 7/8	6¼		23.6	Portland	8	
Production	5 5/8	2 7/8		696/95	Portland	75	2 saks gel

PERFORATION RECORD		Acid, Fracture, Shot, Cement Squeeze Record	
shots per foot	specify footage of each interval perforated	(amount and kind of material used)	Depth
1.5	668 - 676	35 sacks sand 95 bbl water	670 - 6

METHOD OF COMPLETION

Disposition of gas: ☒ vented ☐ sold ☐ used on lease

☐ open hole ☒ perforation
☐ other (specify) .....

☐ Dually Completed.

PRODUCTION INTERVAL

.....