


DX 78-1 Dickinson

KANSAS

Section 22 Township 16 Range 4E

Well No. #1 Martin Dombrosky

Company Augusta Oil

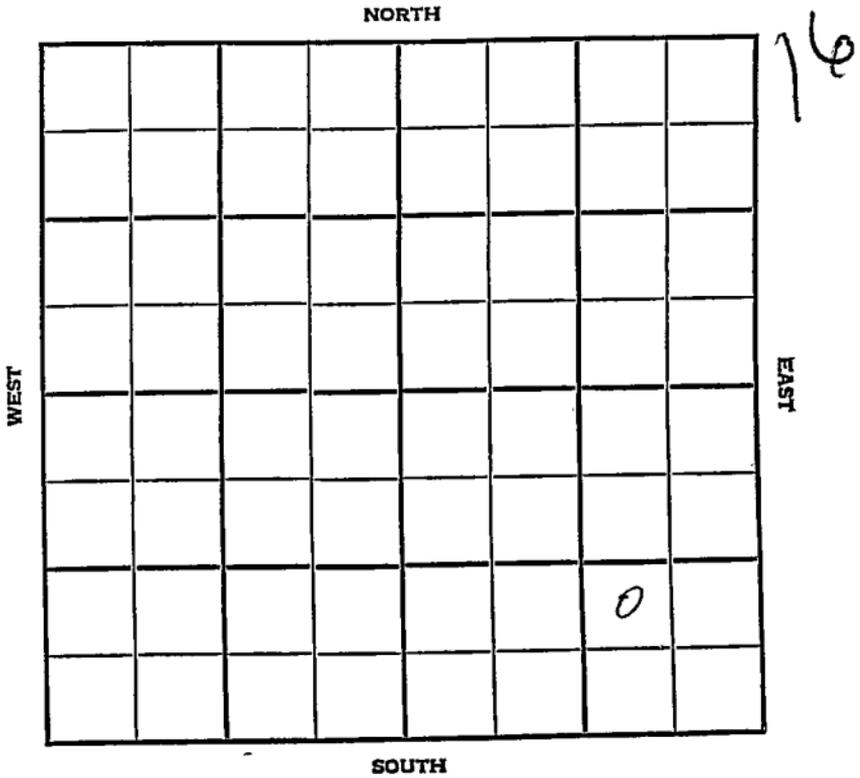

SEC.	TWP.	R.
22	16	4E

WELL NO.

#1 Martin Dombrosky

FARM

COMPANY

Augusta Oil

CONTRACTOR

Co. Tools

Lost Springs


_____ FT. FROM N. LINE

_____ FT. FROM S. LINE

_____ FT. FROM E. LINE

_____ FT. FROM W. LINE

NW SE SE

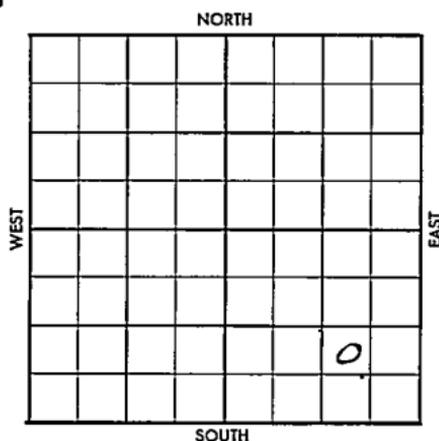

1956	ELEVATION	REPORT
------	-----------	--------

7-11 RUR

7-25 Comm. 7-9-56
 8 5/8" @ 125 w/50
 4 1/2" @ 2300 w/30
 DD 2332
 B/ 2 goph / 45 gwph
 D & A
 M. chat 2282'
 TD 2300'

ABANDONED

No County Map

County Dickinson Elev.
 Sec. 22 Twp. 16 Rgs. 1E
 Company Angusta Oil
 Farm Name Martin Dombrosky No. 1

Co.

TOPS	DEPTH	LOG	DATUM
Anh.			
Tr.			
H.			
Tr.			
Dg.			
Bl.			
L.			
K.C.			
B.K.C.			
Ce.			
C.			
M. <i>char</i>	<i>2282</i>		
M.			
K.			
Mz.			
Mo.			
V.			
S.			
S.			
A.			
R.			
PE.			
G.			
TD.	<i>2300</i>		

Loc. in Sec. NW 5E 5E
 Geol.
 Contr.
 Co. tools
 Pool
 Lost Springs
ABANDONED
 JUL 25 1956
 No.

Loc.

No.

Date Comm. RUR JUL 18 '56 7-9-56 85/8/25
150 4 1/2 @ 2300/30 JUL 25 '55
DD2332 ip 2600h + 45-6wph

Ser.

T.

DEA

R.