


Map No. 1774 Sec. 22 Twp. 16 R. 21E

Well No. 1 unknown Farm

Leeward Pet Company

NORTH

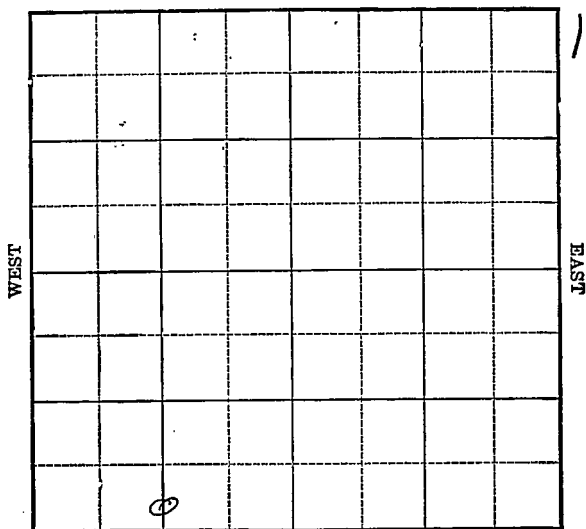

SOUTH

Location _____

Drilling Remarks

RECORD

Cased _____ in. _____ ft.

Sand _____

Gas _____

Oil _____

Total Depth _____

Rig Up _____

Drilling Remarks

PRODUCTION

1st 24 hrs. Nat. _____

1st 24 hrs. after shot _____

Gas _____ cu. ft.


Dry Hole _____

Abandoned _____

Franklin

Map No. NHMP Sec. 22 Twp. 16 R. 21EWell No. 1 unknown FarmLeeward Pet Company

NORTH

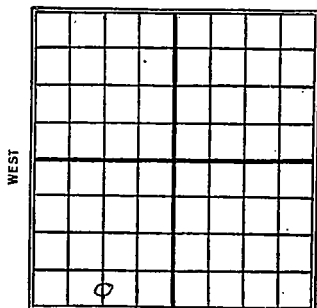

SOUTH

_____ Ft. from N. Line

300 Ft. from S. Line

_____ Ft. from E. Line

1320 Ft. from W. Line1926

Date

REPORT

7/21	Dlg 275'
7/28	Same
8/4	Dlg 1100
8/11	—
8/18	—
8/25	—
8-31	—
9/15	—
9/22	—
9/29	—
10/13	—
10/20	D.O.A. 1497

no KANSAS 22 Twp. 16 R. 21 E
 Map No. Sec. Twp. R.

Well No. 1 Unknown
 Woodward Ref Co
 Company

Contractor

FIRST REPORTS

SECTION PLAT

Ft. from N. Line

300 Ft. from S. Line

Ft. from E. Line

1320 Ft. from W. Line

φ			

Location

Rig up

Drilling and Remarks:

Only 275'

RECORD

Cased in., ft.

Sand

Gas

Oil

Total Depth

PRODUCTION

1st 24 hrs. Nat.

1st 24 hrs. after shot

Gas Cu. Ft.

Dry Hole

Abandoned

Date

JUL 21 1926

CHAS. L. SHERWOOD

192

Scout

no map
KANSASMap No. _____ Sec. 22 Twp. 16 R. 21^EWell No. 1 unknown
Reeward Petroleum Co. Company_____
Contractor

COMPLETED

SECTION PLAT

Ft. from N. Line300

Ft. from S. Line_____
Ft. from E. Line1320

Ft. from W. Line

ABANDONED

Location _____

Rig up _____

Drilling and Remarks:

RECORD

Cased _____ in., _____ ft.

Sand _____

Gas _____

Oil _____

Total Depth 1497

PRODUCTION

1st 24 hrs. Nat. _____

1st 24 hrs. after shot _____

Gas _____ Cu. Ft.

Dry Hole ☒Abandoned ☒

Date

OCT 20 1926

CHAS. L. SHERWOOD

192

Scout