

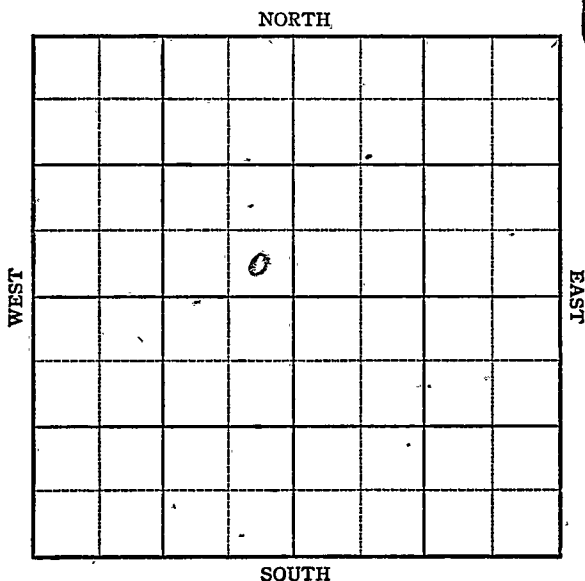
KANSAS

Dickinson county

Section 22 Township 16 Range 4-E

Well No. #1 Huffman

Company J. Lieker etal

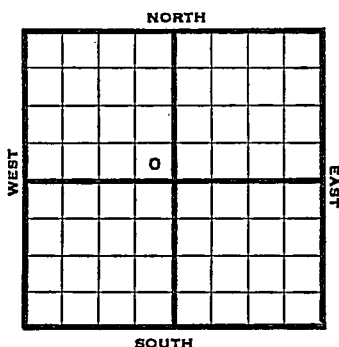


KANSAS

Dickinson

Sec. 22 Twp. 16 R. 4-EWell No. #1 Huffman FarmJ. Lieker et al Company

Lost Spring

 Ft. from N. Line330 Ft. from S. Line330 Ft. from E. Line Ft. from W. Line

SE NW

1947 1388

REPORT

1/29 Location

2/5 " "

2/12 13" @ 110
Drlg 415'2/19 10" @ 894'
Drlg 1150'2/26 8" @ 1640
Drlg 1700'

3/4 Drlg 2190'

3/12 Miss 2282
7" @ 2218'
Pump 20 Pot
Grav. 36
TD 2315'

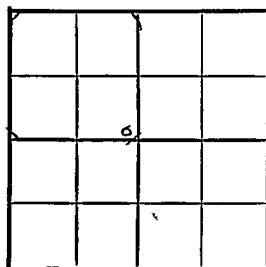
COMPLETED

Kansas KANSAS

Map No. 26 Sec. 22 Twp. 16 R. 4EWell No. 1 HuffmanJ. Lieker et al. Company**FIRST REPORT** Contractor

SE NW

SECTION PLAT

 Ft. from N. Line330 Ft. from S. Line330 Ft. from E. Line Ft. from W. Line

Dickinson County

Location XRig up

Drilling and Remarks:

RECORD

Cased in., ft.Sand Gas Oil Total Depth

PRODUCTION

1st 24 hrs. Nat. 1st 24 hrs. after shot Gas Cu. Ft.Dry Hole Abandoned

Date

JAN 2 9 1947 19 S. J. LEWIS Scout

Map No. 26 Sec. 22 Twp. 16 R. 4EWell No. 1 HuffmanJ. Lieker et al. Company

COMPLETE

Contractor

SE NW

E11388

SECTION PLAT

 Ft. from N. Line330 Ft. from S. Line330 Ft. from E. Line Ft. from W. Line

Dickinson County

Location Rig up

Drilling and Remarks:

*Mus 2282**7' @ 2215'**Pump. 2025'**36 2/3'*

RECORD

Cased in., ft.Sand Gas Oil Total Depth 2215'

PRODUCTION

1st 24 hrs. Nat. 1st 24 hrs. after shot Gas Cu. Ft.Dry Hole Abandoned

Date

MAR 12 1947 19

S. J. LEWIS Scout