


KANSAS

Dickinson county
Lost Spring

Section 22 Township 16 Range 4E

Well No. 2 Schlessinger

Company J. Leiker

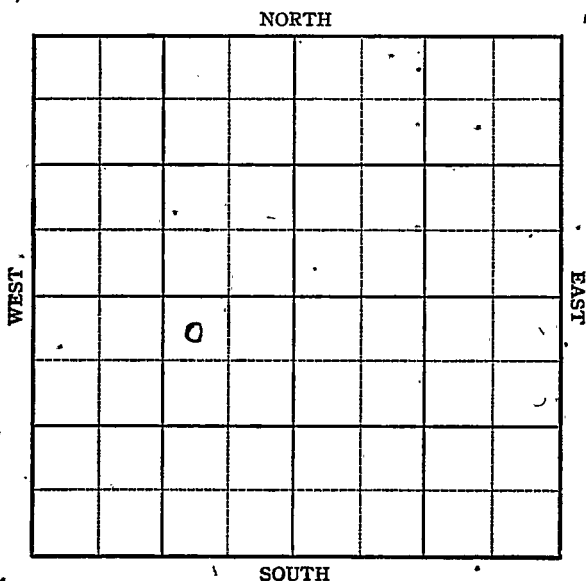

KANSAS

Dickinson

Sec. 22 Twp. 16 R. 4-E

Well No. #2 Schlessinger Farm

J. Leiker Company


Lost Spring

330 Ft. from N. Line

Ft. from S. Line

990 Ft. from E. Line

Ft. from W. Line

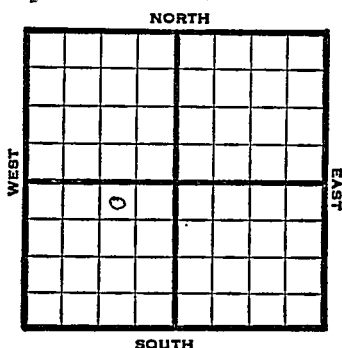

NW NE SW

REPORT

1947

4/16 8" @ 124'
Drlg 185'

4/23 KC 1780'
Drlg 1864'

4/29 Chab 2264-69
TD 2269'
5" @ 2264'
RUST

5/7 Chat 2264
5" @ 2264'
TD 2205'

ABANDONED

Map No. K26 Sec. 22 Twp. 16 R. 4E

Well No. 2 Schlessinger

J. Leiker Company

FIRST REPORT

Contractor

NW NE SW

SECTION PLAT

330 Ft. from N. Line

 Ft. from S. Line

990 Ft. from E. Line

 Ft. from W. Line

	a		

Dickinson County

Location

Rig up

Drilling and Remarks:

8" @ 124

drlg. 185

RECORD

Cased in., ft.

Sand

Gas

Oil

Total Depth

PRODUCTION

1st 24 hrs. Nat.

1st 24 hrs. after shot

Gas Cu. Ft.

Dry Hole

Abandoned

Date

APR 16 1947 19

S. J. LEWIS Scout

Kansas

KANSAS Lost Spring Pool

Map No. 1526 Sec. 22 Twp. 16 R. 4EWell No. 2 SchlessingerJ. Leiker

Company

ABANDONED

Contractor

NW NE SW

SECTION PLAT

330 Ft. from N. Line

Ft. from S. Line

990 Ft. from E. Line

Ft. from W. Line

	6		

Dickinson County

Location

Rig up

Drilling and Remarks:

Chas 2264
5" @ 2264

RECORD

Cased _____ in., _____ ft.

Sand _____

Gas _____

Oil _____

Total Depth 2205

PRODUCTION

1st 24 hrs. Nat. _____

1st 24 hrs. after shot _____

Gas _____ Cu. Ft.

Dry Hole _____

Abandoned _____

Date

MAY 7 1947

19

S. J. LEWIS Scout