


# KANSAS Dickinson

FORM 51 5M PETROL

Section 22 Township 16 Range 4E

Well No. 1 L. R. Hird

Company Oil Well Drlg.

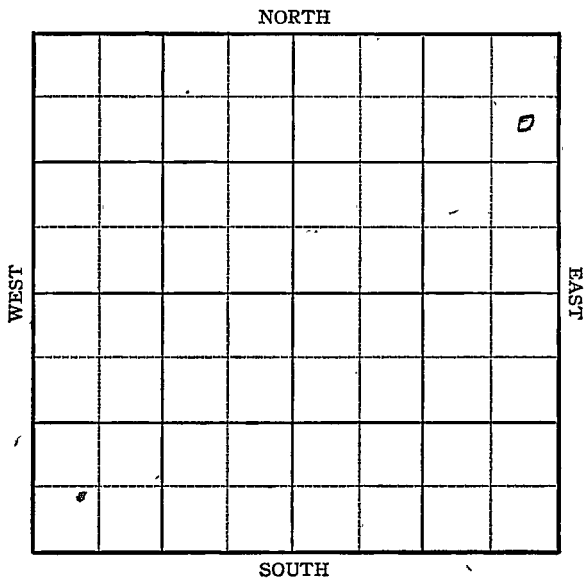

Sec. 22 Twp. 16 R. 4E

Well No. #1 L. R. Hird Farm

Oil well Drlg. Company

Lost Spring North

920 Ft. from N. Line


\_\_\_\_\_ Ft. from S. Line

360 Ft. from E. Line

\_\_\_\_\_ Ft. from W. Line

SE NE NE

Elev. 1400

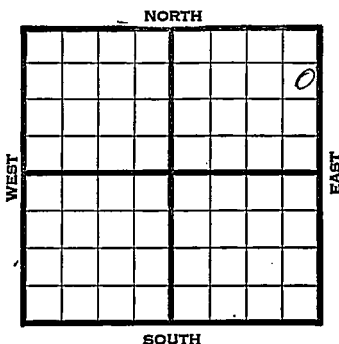

1945

REPORT

7/25	Location
8/1	RUR
8/8	8" @ 131 Drlg. 400
8/15	Drlg. 2195
8/22	Miss. 2280 TD 2289 5" @ 2289 RUST
8/29	" " "
9/5	TD 2310 1800' oil 16 hrs.
9/12	Shut down
9/19	Estimate 50 oil a day
9/26	" " "
10/3	" " "
10/10	" " "
10/17	" " "
10/24	" " "
10/31	" " "
11/7	" " "
11/14	" " "
11/21	" " "
11/28	" " "
12/5	Miss. 2280 TD 2345'

ABANDONED

Kansas Pool Name Lost Spring North

Map No. 26 Sec. 22 Twp. 16 R. 4E

Well No. 1 L. R. Hird

Oil well drlg. \_\_\_\_\_ Company \_\_\_\_\_

FIRST REPORT \_\_\_\_\_ Contractor \_\_\_\_\_

SE NE NE

SECTION PLAT

920 Ft. from N. Line

\_\_\_\_\_ Ft. from S. Line

360 Ft. from E. Line

\_\_\_\_\_ Ft. from W. Line


Dickinson

Location X

Rig up \_\_\_\_\_

Drilling and Remarks:

RECORD

Cased \_\_\_\_\_ in., \_\_\_\_\_ ft.

Sand \_\_\_\_\_

Gas \_\_\_\_\_

Oil \_\_\_\_\_

Total Depth \_\_\_\_\_

PRODUCTION

1st 24 hrs. Nat. \_\_\_\_\_

1st 24 hrs. after shot \_\_\_\_\_

Gas \_\_\_\_\_ Cu. Ft.

Dry Hole \_\_\_\_\_

Abandoned \_\_\_\_\_

Date

JUL 25 1945 19

S. J. LEWIS Scout

KANSAS

Kansa Pool Name Lost Spring NorthMap No. 11-26 Sec. 22 Twp. 16 R. 4EWell No. 1 L. R. Hird

Oil Well Drlg. \_\_\_\_\_ Company \_\_\_\_\_

ABANDONED \_\_\_\_\_ Contractor \_\_\_\_\_

SE NE NE

E11400  
SECTION PLAT920 Ft. from N. Line

\_\_\_\_\_ Ft. from S. Line

360 Ft. from E. Line

\_\_\_\_\_ Ft. from W. Line

			0

Dickinson County

Location \_\_\_\_\_

Rig up \_\_\_\_\_

Drilling and Remarks:

Miss 2280

## RECORD

Cased \_\_\_\_\_ in., \_\_\_\_\_ ft.

Sand \_\_\_\_\_

Gas \_\_\_\_\_

Oil \_\_\_\_\_

Total Depth 2845

## PRODUCTION

1st 24 hrs. Nat. \_\_\_\_\_

1st 24 hrs. after shot \_\_\_\_\_

Gas \_\_\_\_\_ Cu. Ft.

Dry Hole \_\_\_\_\_

Abandoned \_\_\_\_\_

Date

DEC 5 1945

19

S. J. LEWIS Scout