


Dickinson county

Section 22 Township 16 Range 4-E

Well No. ~~#2 - Dombrowski~~ #1 - H. Schlossener

Company J. Leiker etal

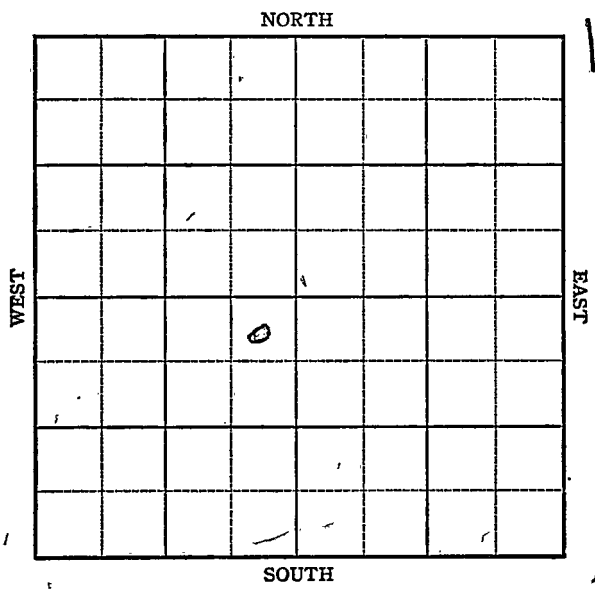

Sec. 22 Twp. 16 R. 4E

Well No. 1 N of Ch. Lesioner
~~2 Dombrowski~~ Farm

J. Leiker Etal Company


Lost Spring

330 Ft. from N. Line

Ft. from S. Line

330 Ft. from E. Line

Ft. from W. Line

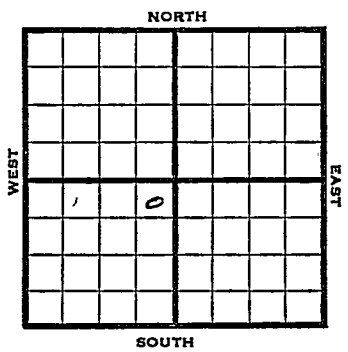

NE SW

1947		Elev. 1364'	REPORT
1/2		RUR	
1/8		SD	
1/15		8" @ 135 Drlg 990'	
1/21		Drlg 2039'	
1/30		Miss. 2240 5" @ 2247 TD 2263' 650' fluid 1 hr 50% W	
2/5		" " "	
2/12		" " "	
2/19		" " "	
2/26		" " "	
3/5		Miss 2240 5" @ 2247 Pump 35 Pot Grav. 38 TD 2265'	

COMPLETED

Kansas

Lost Spring
KANSASMap No. 26 Sec. 22 Twp. 16 R. 4EWell No. 2 DombrowskiJ. Leiker et al. Company**FIRST REPORT**

Contractor

NE SW

SECTION PLAT

	o		

330 Ft. from N. Line

_____ Ft. from S. Line

330 Ft. from E. Line

_____ Ft. from W. Line

Dickinson County

Location _____

Rig up _____

Drilling and Remarks:

R U R

RECORD

Cased _____ in., _____ ft.

Sand _____

Gas _____

Oil _____

Total Depth _____

PRODUCTION

1st 24 hrs. Nat. _____

1st 24 hrs. after shot _____

Gas _____ Cu. Ft.

Dry Hole _____

Abandoned _____

Date

JAN 2 1947 19S. J. LEWIS Scout

Map No. 26 Sec. 22 Twp. 16 R. 4E

Well No. 1 H. Schlessener

J. Leiker et al. Company

CORRECTION Contractor

NE SW

330 Ft. from N. Line

_____ Ft. from S. Line

330 Ft. from E. Line

_____ Ft. from W. Line

SECTION PLAT

	o		

Dickinson County

Location _____

Rig up _____

Drilling and Remarks:

Reported
#2 Dombrowski

RECORD

Cased _____ in., _____ ft.

Sand _____

Gas _____

Oil _____

Total Depth _____

PRODUCTION

1st 24 hrs. Nat. _____

1st 24 hrs. after shot _____

Gas _____ Cu. Ft.

Dry Hole _____

Abandoned _____

Date

JAN 8 1947 19

S. J. LEWIS

Scout

Kansas **KANSAS**Map No. 7.6 Sec. 22 Twp. 16 R. 4EWell No. 1 H. SchlessenerJ. Leiker et al. Company**COMPLETE**

Contractor

NE SW

E11364
SECTION PLAT330 Ft. from N. Line

_____ Ft. from S. Line

330 Ft. from E. Line

_____ Ft. from W. Line

Dickinson County

Location _____

Rig up _____

Drilling and Remarks:

*Miss 2240**5" @ 2247.**Aug 25 1947**28 3/4***RECORD**

Cased _____ in., _____ ft.

Sand _____

Gas _____

Oil _____

Total Depth 2265**PRODUCTION**

1st 24 hrs. Nat. _____

1st 24 hrs. after shot _____

Gas _____ Cu. Ft.

Dry Hole _____

Abandoned _____

Date

MAR 5 1947 19S. J. LEWIS Scout