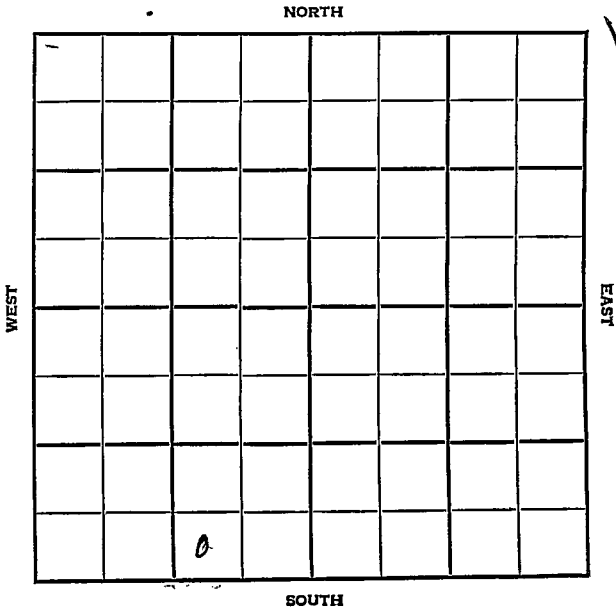


Section 22 Township 16 Range 1EWell No. #1 DombrowskiCompany Daetwiller et al

Dickinson KANSAS

SEC.	TWP.	R.
22	16	4E ✓

WELL NO.

1 Dombrowski

FARM

COMPANY

Daetwiller et al

CONTRACTOR

Slusser Drlg.

Lost Springs Pool

NORTH

Ft. from N. Line

330


330 _____ Ft. from S. Line

990

990 _____ Ft. from E. Line

Ft. from W. Line

SW SE SW

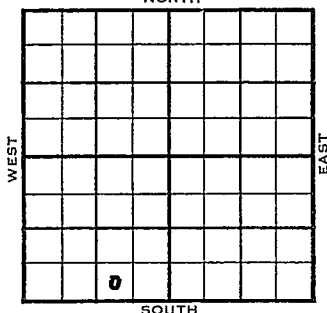

1954

ELEVATION

000000

REPORT

4/27

Spud 4-26-54

5/12


S_{pu}d 4-26-54 8" @ 70

Miss 2230 TD 2280' D & A

ABANDONED

J. G. McGEHEE

County Dickinson State Kansas
 Sec. 22 (Blk. 16 (Sur. 4E Map No.
 Operator Daetwiller etal.
 Well No. 1 Farm Dombrowski
 Elev. Location SW SE SW

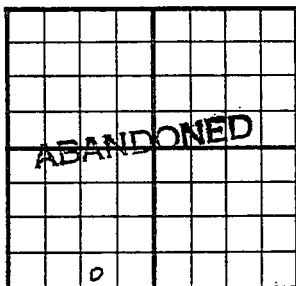

330 Ft. From S Line SW
990 Ft. From E Line Quarter
 Ist. Report
 Completion MAY 12 1954
 Remarks Lost Springs Pool
Slusser Drlg. - Contr.
 Spudding Date 4-26-54

Drlg. Data

8" @ 70 Miss. 2230 TD 2280

D & A

J. G. McGEHEE