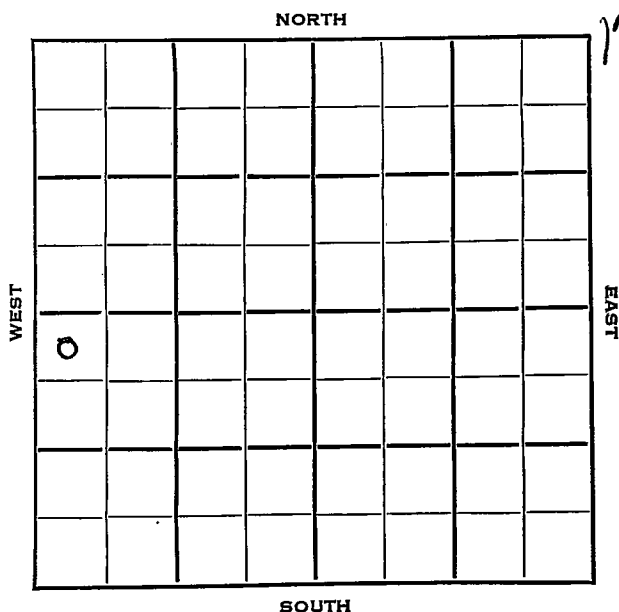


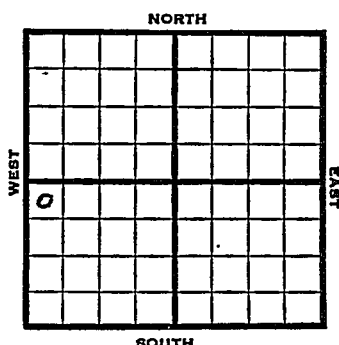
Section 24 Township 16 Range 5EWell No. #1 BrechbillCompany Koester & Mergen et al.

Morris KANSAS ✓

Sec. 24 Twp. 16 R. 5EWell No. #1 Brechbill FarmKoester & Mergen et al CompanySlusser Drlg. ContractorWildcat
330 Ft. from N. Line

Ft. from S. Line

Ft. from E. Line

330 Ft. from W. LineNW NW SW
Koch Oil - acreage

1953 Elev. 1482' REPORT

4/22 Location

5/20 Spud 4-26-53

D&A

TD 2284

8" @ 178

Miss 2227

TD 2229

5" @ 2229

DD 2250, FU 150' wtr., 12 hrs.

DD, FU 350' oil, 350' wtr 15 hrs.

Kh 2281

TD 2284

FU 75' oil 675' wtr. 12 hrs.

42/2258-65, oil & wtr.

D&A

ABANDONED

County Morris State KansasSec. 24 (Blk.) 16 (Sur.) 5E Map No.Operator Koester & Mergen et al.Well No. 1 Farm BrechbillElev. Location NW NW SW

330 Ft. From N Line SW330 Ft. From W Line Quarter1st. Report APR 22 1953

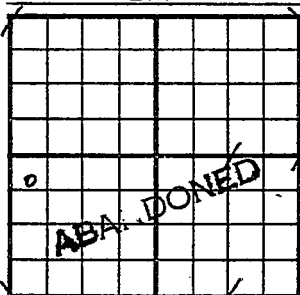
Completion

Remarks Koch Oil - acreageSlusser Drlg. - Contr.

Spudding Date

Drlg. Data WildcatLocation

 Sec. 24 (Blk. 16) (Sur. 5E) Map No. 16
 Operator Koester & Mergen et al.
 Well No. 1 Farm Brechbill
 Elev. 1482 Location NW NW SW

330 Ft. From N Line SW330 Ft. From W Line Quarter

1st. Report

Completion MAY 20 1953Remarks WildcatSlusser Drlg. - Contr.Spudding Date 4-26-53Drlg. Data D & A TD 22848" @ 178 Miss. 2227 TD 2229 5" @ 2229DD 2250 FU 150' wtr. 12 hr. DDFU 350' oil 350' wtr. 15 hr.Kh. 2281 TD 2284 FU 75' oil 675' wtr.12 hr. 42/ 2258-65 oil & wtr.D & A

J. G. McGEHEE