

Section 24 Township 16 Range 5EWell No. #1 BreckbillCompany Lincoln Oil

NORTH

							0

WEST

EAST

SOUTH

16

Morris

KANSAS

Sec. 24 Twp. 16 R. 5E

Well No #1 Brackbill Farm

Lincoln Oil Company


Contractor

 Ft. from N. Line

990' Ft. from S. Line

330' Ft. from E. Line

 Ft. from W. Line

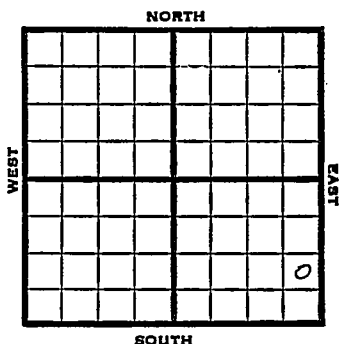

NE SE SE

1950 Elev. 1472' REPORT

12/20 Location

2/28 Spud 1-6-51
D&A TD 3069
8-5/8" @ 157
Miss 2183

DST 2177-2228 opn $\frac{1}{2}$ hr

Rec. 200' mud

Kinderhook 2251' Hunton 2421

Shale 2570 Viola 2641

Simp. 2727 A^hb. 2808

DST 2810-2983 opn 15 min

Rec. 2400' wtr

Granite 3066' TD 3069'

D&A

ABANDONED

2421
2143
238

County **Morris** State **Kansas**

Sec. 24 (Blk. 16 (Sur. 5E Twp.) Rge.) Map No.

Operator Lincoln Oil

Well No. 1 Farm Breckbill

Elev.	Location	NE	SE	SE
-------	----------	----	----	----

990 Ft. From S Line SE

330 Ft. From E Line Quarter

1st. Report DEC 20 1950

Completion _____

Remarks


Mendenhall - Contr.

Spudding Date

Drig. Data	Wildcat
------------	---------

Location

J. E. TYRA

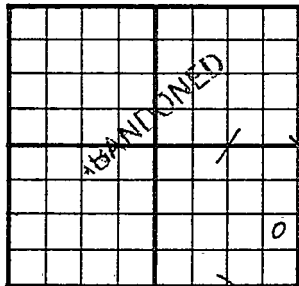County Morris State KansasSec. 24 (Blk.) 16 (Sur.) 5E Map No.Operator Lincoln OilWell No. 1 Farm BreckbillElev. 1472 Location NE SE SE990 Ft. From S Line SE330 Ft. From E Line Quarter

1st. Report

Completion FEB 28 1951Remarks WildcatMendenhall - Contr.Spudding Date 1-6-51Drlg. Data D & A TD 30698 5/8" @ 157 Miss. 2183 DST 2177-2228open $\frac{1}{2}$ hr. Rec. 200' mud Kinderhook 2251Hunton 2421 Shale 2570 Viola 2641Simp. 2727 Arb. 2808 DST 2810-2983open 15 min. Rec. 2400' waterGranite 3066-69, TDD & A

J. E. TYRA