


Map No. KANSAS Sec. 24 Twp. 16 R. 9E

Well No. 1- Toward Farm
Hankerson et al Company

_____ Ft. from N. Line
250 Ft. from S. Line
 _____ Ft. from E. Line
250 Ft. from W. Line

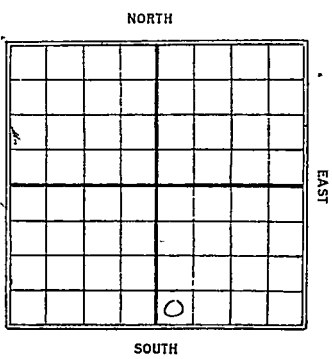

1930

Date	REPORT
3/26	Rig
4/2	8/27
4/9	9/2
4/16	9/9
4/23	9/16
4/30	9/24
5/7	10/11
5/14	10/18
5/27	10/15
5/4	10/22
6/11	10/29
6/18	11/5
6/25	11/12
7/2	11/19
7/9	11/26
7/16	12/2- Abandon
7/23	location
7/30	
8/6	
8/13	
8/20	

Morris

Map No. KANSAS Sec. 24 Twp. 16 R. 9

Well No. 1 Howard

Hankenson & Co Company

Contractor

COMPLETE

SECTION PLAT

..... Ft. from N. Line

250 Ft. from S. Line

..... Ft. from E. Line

250 Ft. from W. Line

ABANDONED

Location.....

Rig up.....

Drilling and Remarks:

Rig Abandoned

RECORD

Cased..... in. ft.

Sand.....

Gas.....

Oil.....

Total Depth.....

PRODUCTION

1st 24 hrs. Nat.....

1st 24 hrs. after shot.....

Gas..... Cu. Ft.

Dry Hole.....

Abandoned..... *Rig*

Date

DEC 3 1930

CHAS. L. SHERWOOD

Morris

KANSAS

Map No. _____ Sec. *24* Twp. *16* R. *9^E*

Well No. *1* *Haward*

Hankenson et al Company

Contractor

FIRST REPORTS

SECTION PLAT

_____ Ft. from N. Line

750 Ft. from S. Line

_____ Ft. from E. Line

750 Ft. from W. Line

Location _____

Rig up

Drilling and Remarks:

RECORD

Cased _____ in., _____ ft.

Sand _____

Gas _____

Oil _____

Total Depth _____

PRODUCTION

1st 24 hrs. Nat. _____

1st 24 hrs. after shot _____

Gas _____ Cu. Ft.

Dry Hole _____

Abandoned _____

Date

MAY 26 1930

192 **CHAS. L. SHERWOOD**

Scout