


Dickinson

KANSAS

SECTION 25 TOWNSHIP 16 RANGE 4E

WELL NO. #1 Hoffman

COMPANY Augusta Oil

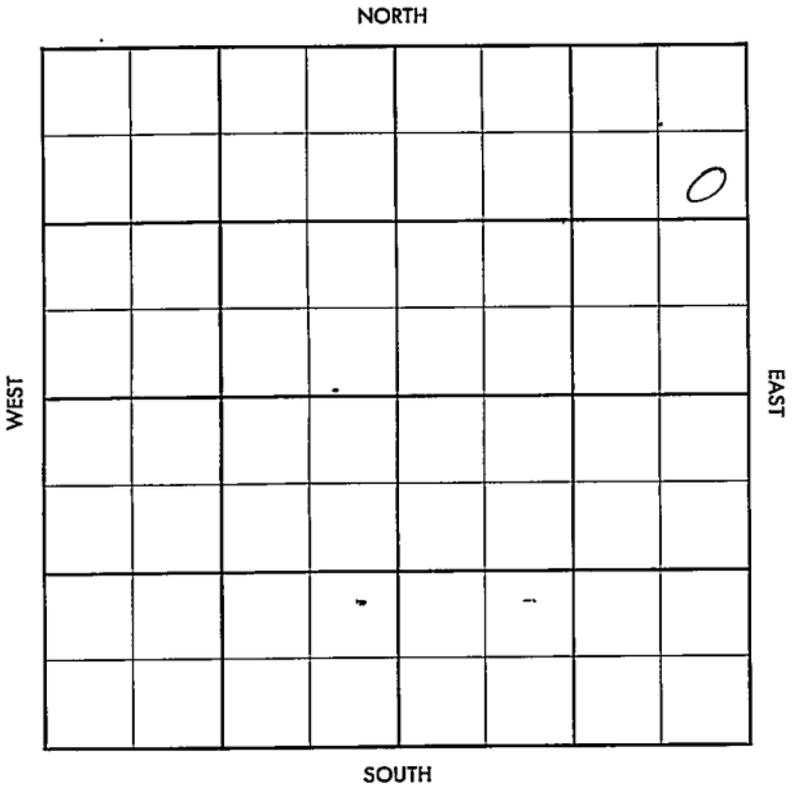

SEC. 25	TWP. 16	R. 4E
------------	------------	----------

WELL NO.

#1 Hoffman

FARM

COMPANY

Augusta Oil

CONTRACTOR

Co. Tools


WILDCAT

_____ Ft. from N. Line

_____ Ft. from S. Line

_____ Ft. from E. Line

_____ Ft. from W. Line

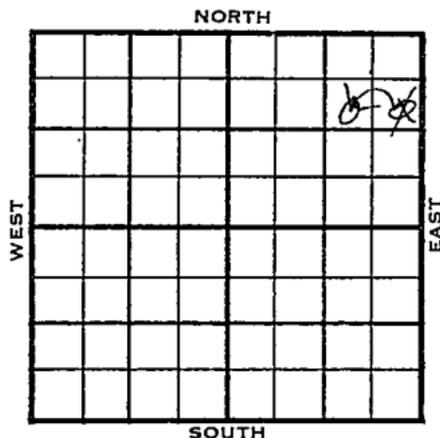SE NE NE
Sw

1956	ELEVATION	REPORT
------	-----------	--------

5-16 Comm. 5-14-56

5-23 8 5/8" @ 180 w/125

D& A

KC 1685', M. Base 2310', M. 2253',
 Hunt 2473', V. 2691', Syl. Sh. 2625'.
 TD 2723'

ABANDONED

$$\begin{array}{r} 2473 \\ 2253 \\ \hline 220 \end{array}$$

No County Map

County Dickinson Elev. _____
 Sec. 25 Twp. 16 Rgs. 1E
 Company Augusta Oil
 Farm Name Hoffman No. 1

TOPS	DEPTH	LOG	DATUM
Anh.			
Tp.			
H.			
Tr.			
Dg.			
Bl.			
L.			
K.C.			
B.K.C.			
Ce.			
C.			
M.			
M.			
K.			
Mz.			
Mo.			
V.			
S.			
S.			
A.			
R.			
PE.			
G.			
T.D.			

Loc. in Sec. SE NE NE
 Geol. _____
 Contr. _____
 Co. tools _____
 Pool Wildcat

MAY 16 1956
 FIRST REPORT

Date Comm. 5-14-56


D.R.

Co.

Lse.

No.

Sec.

T.

R.