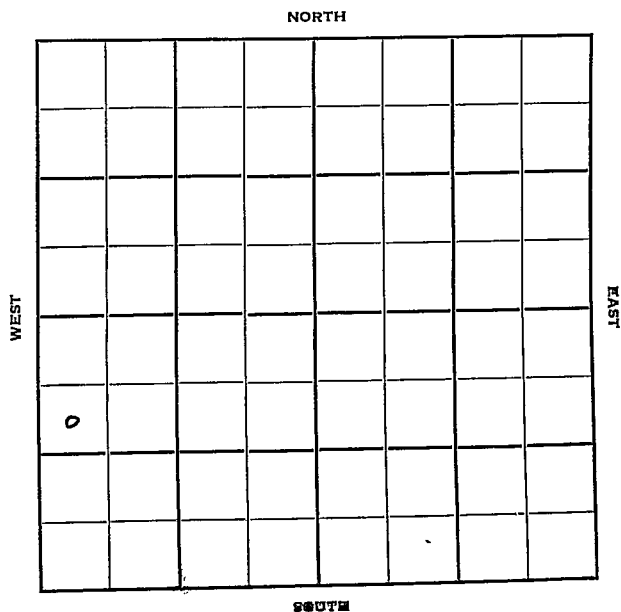


Section 25 Township 16 Range 5 EWell No. 1 BurnsCompany Ed Kester & Murfin et al

KANSAS

Morris

Sec. 25 Twp. 16 R. 5E

Well No. #1 Burns Farm

Ed Kester & Mufin etal Company

Contractor

Wildcat


990 Ft. from N. Line

Ft. from S. Line

Ft. from E. Line

330 Ft. from W. Line

SW NW SW

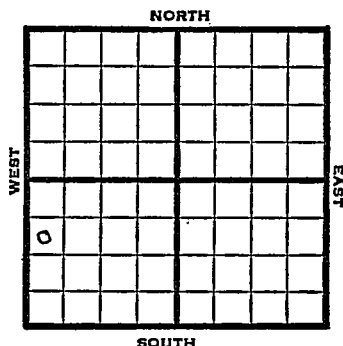

1950

Elev. 1464' REPORT

5/10
6/7

Location

8-5/8" @ 142'

Lans. 1685'

Miss 2207'

5 1/2" @ 2208'

40 BOPD

TD 2252'

COMPLETED

Kansas Wildcat

Map No. _____ Sec. 25 Twp. 16 R. 5E

Well No. 1 Burns

Ed Kester & Murfin etal Company

Contractor

SW NW SW

SECTION PLAT

990 Ft. from N. Line

Ft. from S. Line

Ft. from E. Line

330 Ft. from W. Line

FIRST REPORT			

Morris

Location Y

Rig up

Drilling and Remarks:

RECORD

Cased _____ in., _____ ft.

Sand _____

Gas _____

Oil _____

Total Depth _____

PRODUCTION

1st 24 hrs. Nat. _____

1st 24 hrs. after shot _____

Gas _____ Cu. Ft.

Dry Hole _____

Abandoned _____

Date

MAY 10 1950 19

J. E. TYRA

Scout

Kansas

Map No. _____ Sec. 25 _____ Twp. 16 _____ R. 5E _____

Well No. 1 Bunns _____

Ed Kester & Murfin et al _____ Company _____

_____ Contractor _____

SW NW SW

El. 1464
SECTION PLAT

990 _____ Ft. from N. Line

_____ Ft. from S. Line

_____ Ft. from E. Line

330 _____ Ft. from W. Line

		COMPLETE	
⊙			

Morris _____

Location _____

Rig up _____

Drilling and Remarks:

8 5/8" @ 142
 Lens 1685
 Min 2207
 5 1/2" @ 2208
 40 B.O.P.D.

RECORD

Cased _____ in., _____ ft.

Sand _____

Gas _____

Oil _____

Total Depth 2252 _____

PRODUCTION

1st 24 hrs. Nat. _____

1st 24 hrs. after shot _____

Gas _____ Cu. Ft.

Dry Hole _____

Abandoned _____

Date

JUN 7 1950 19 _____

J. E. TYRA _____ Scout