

Morris

KANSAS

Section 25 Township 16 Range 5E

Well No. #2 Burns

Company Koester & Mergen

NORTH

WEST

EAST

	0						

SOUTH

12

Morris

KANSAS

Sec. 25 Twp. 16 R. 5E ✓

Well No. #2 Burns Farm

Koester & Mergen Company

Contractor


330' Ft. from N. Line

Ft. from S. Line

Ft. from E. Line

990' Ft. from W. Line

NE NW SW

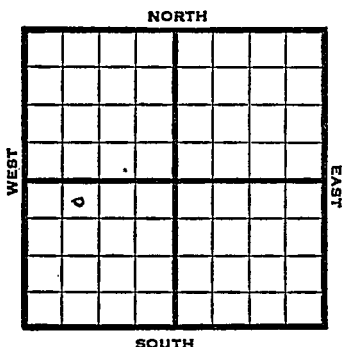

1950

Elev. 1453'

REPORT

8/30

Cellar & Pits

12/13

Spud 8-4-50

D&A TD 2227

8" @ 150' Miss 2182-2213

DST 2182-2213 opn 1 hr Rec. 120' ocm

BHP 533# 5" @ 2185 TD 2227


FU 300' oil 500' wtr PB 2232

25 qt 2219-22

D&A

ABANDONED

County Morris State Kansas
 Sec. 25 (Blk. 16 (Sur. 5E Map No.
 (Twp.) (Rgs.)
 Operator Koester & Mergen
 Well No. 2 Farm Buras
 Elev. Location NE NW SW

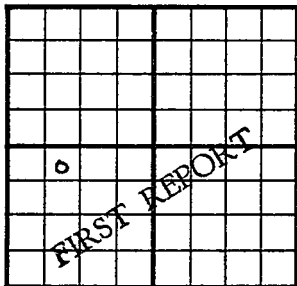

330 Ft. From N Line SW
990 Ft. From W Line Quarter
 1st. Report AUG 30 1950

Completion

Remarks


Spudding Date

Drlg. Data 3 mile Creek Pool

Cellar & pits

J. E. TYRA

County Morris State Kansas
 Sec. 25 (Blk.) 16 (Sur.) 5E Map No.
 Operator Koester & Mergen
 Well No. 2 Farm Burns
 Elev. 1453 Location NE NW SW

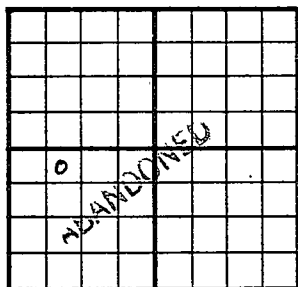

330 Ft. From N Line SW
990 Ft. From W Line Quarter
 1st. Report
 Completion DEC 13 1950
 Remarks 3 mile Creek

Spudding Date 8-4-50

Drig. Data D & A TD 2227

8" C 150 Miss. 2182-2213 DST 2182-2213

open 1 hr. Rec. 120' ocm BHP 533#

5" @ 2185 TD 2227 FU 300' oil 500' wat

PB 2232 25 qt/ 2219-22

D & A

J. E. TYRA